

SURVEY &  
REMONUMENTATION

OCT 24 1994

COMMISSION

OTTAWA COUNTY REMONUMENTATION  
LAND CORNER RECORDATION CERTIFICATE  
Filing Requirement of Act 74, Mich. P.A. 1970

RECORDED

94 OCT -7 PM 12:34

For corners in

Ottawa (County)	Located In:	Corner Code #
1. Public Land Survey	T 9N R 13W	E-8, E 1/4 COR. Sec. 20, Chester
	T R	
	T R	
	T R	
2. Property Controlling in Section	S T R	
	S T R	
3. Miscellaneous Property in Sec.	S T R	
	S T R	
4. Lot No. _____, Recorded Plat _____		
5. Private Claims _____		

*R. G. ...*  
REGISTER OF DEEDS  
OTTAWA COUNTY, MI

Register of Deeds Stamp & File Number

I, Randal D. Feenstra in a field survey on April 28, 19 94, do hereby certify that under requirements of P.A. 74, Michigan P.A. of 1970, the corner points mentioned in lines 1 and 2 above were in conformance with regulations and rules therefore as required in the current manual of survey instructions of the United States Department of the Interior, Bureau of Land Management or by a decree of a Court of Law and/or that the corner points mentioned in lines 3, 4 and 5 above were in conformance with the rules of the Michigan Board of Land Surveyors or by a Decree of a Court of Law; established, re-established, monumented, re-monumented, recovered, found as expressed below:

**NOTE: Not more than 4 corners, all in the same town and range, may be recorded on this certificate.**

	A	B	C	D	E	F	G	H	I	J	K	L	M
2	6	5	4	3	2	1							
3													
4	7	8	9	10	11	12							
5													
6	18	17	16	15	14	13							
7													
8	19	20	21	22	23	24							
9													
10	30	29	28	27	26	25							
11													
12	31	32	33	34	35	36							
13													

A. Description of original monument and accessories and/or subsequent restoration:

G.L.O. (1838)	Liber 5, Page 104 (1984)	Liber 6, Page 112 (1991)
24" Elm S41°E 22.4'	4" Iron in Mon. Box	CAST IRON MONUMENT
8" Elm S52°W 17.8'	CL South end conc. culv. SE 41.65	Top of fence post WSW 41.97
POST	CL North end conc. culv. E 30.60	14" Poplar NW 42.24
Rasselas Whitcomb	Nail in top of 2"x12" fence post W 38.39	3" Maple NE 79.00

B. Description of corner evidence found and/or method applied in restoring or reestablishing corner:

Found: Cast iron monument in monument box (no cover) accepted as a careful and faithful perpetuation of the position of the original corner.


Found Witnesses:

CL N end 12" conc. culv.	E 30.62
CL S end 12" conc. culv.	SE 41.49

C. Description of monument for corner and accessories established to perpetuate locating the position of the corner:

E-8 Cast iron monument in monument box (no cover)	N65°W 42.25'
O.C. Remon. Nail & Tag in NE side 14" Maple	N80°W 49.35'
1/2" pipe in W side conc. transformer pad	N85°E 30.02'
Chiseled "X" in N end 12" conc. culv.	S45°E 41.49'
Chiseled "X" in S end 12" conc. culv.	
On C. 32nd Avenue	

P.A. 345 OTTAWA COUNTY  
PEER APPROVED *[Signature]*  
*Randal D. Feenstra*

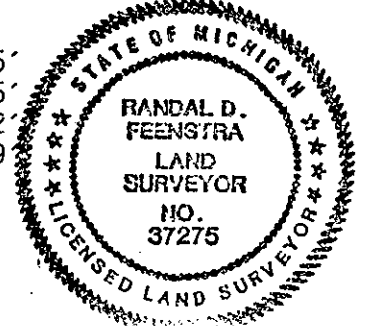

Signed by *Randal D. Feenstra* Date April 28, 1994

Surveyor's Michigan License No. 37275