

SURVEY & REMONUMENTATION

OCT 24 1994

COMMISSION

**OTTAWA COUNTY REMONUMENTATION
LAND CORNER RECORDATION CERTIFICATE
Filing Requirement of Act 74, Mich. P.A. 1970**

RECORDED

OCT -7 PM 12:34

Rhonda Robinson
REGISTER OF DEEDS
OTTAWA COUNTY, MI

For corners in
Ottawa
(County)

Located In: Corner Code #

- | | | |
|---------------------------------------|--------------------------|-------------------------------------|
| 1. Public Land Survey | T <u>9N</u> R <u>13W</u> | E-12, E 1/4 COR
Sec. 32, Chester |
| | T _____ R _____ | _____ |
| | T _____ R _____ | _____ |
| | T _____ R _____ | _____ |
| 2. Property Controlling in Section | S _____ T _____ R _____ | _____ |
| | S _____ T _____ R _____ | _____ |
| 3. Miscellaneous Property in Sec. | S _____ T _____ R _____ | _____ |
| | S _____ T _____ R _____ | _____ |
| 4. Lot No. _____, Recorded Plat _____ | | |
| 5. Private Claims _____ | | |

Register of Deeds Stamp & File Number

I, Randal D. Feentra in a field survey on May 9, 1994, do hereby certify that under requirements of P.A. 74, Michigan P.A. of 1970, the corner points mentioned in lines 1 and 2 above were in conformance with regulations and rules therefore as required in the current manual of survey instructions of the United States Department of the Interior, Bureau of Land Management or by a decree of a Court of Law and/or that the corner points mentioned in lines 3, 4 and 5 above were in conformance with the rules of the Michigan Board of Land Surveyors or by a Decree of a Court of Law; established, re-established, monumented, re-monumented, recovered, found as expressed below:

A	B	C	D	E	F	G	H	I	J	K	L	M
2	6	5	4	3	2	1						
3												
4	7	8	9	10	11	12						
5												
6	18	17	16	15	14	13						
7												
8	19	20	21	22	23	24						
9												
10	30	29	28	27	26	25						
11												
12	31	32	33	34	35	36						
13												

NOTE: Not more than 4 corners, all in the same town and range, may be recorded on this certificate.


A. Description of original monument and accessories and/or subsequent restoration:
 .L.O. (1838) Liber 1, Page 22 (Jan. '72) Liber 1, Page 619 (Aug '72)
 5" Sugar N13°E 7.9' Bolt Spike in Mon. Box Iron in Mon. Box
 8" Sugar S15°W 5.3' St. Sign S47°E 40.65' TP 70.96 NE
 OST CP Pole S45°W 49.53' PP 49.95 SW
 asselas Whitcomb MBT Pole N62°W 74.30' PP 74.50 NW
ber 5, Page 7 (1982)
 I.M.
 wer Pole 49.87 SW
 le Pole 74.64 NW
 le Pole 71.62 SE Tele Pole 70.98 NE

B. Description of corner evidence found and/or method applied in restoring or reestablishing corner:
 Found: Cast Iron Mon. in Mon. Box - accepted as a careful and faithful perpetuation of the position of the original corner.

Found Witnesses:
 Pk Nail in W side PP NE 70.81'
 Nail in E side PP SE 71.60'
 Nail in N side PP SW 49.86'

PA. 345 OTTAWA COUNTY
PEER APPROVED 9/22/94
Robert P. Redwell

C. Description of monument for corner and accessories established to perpetuate locating the position of the corner:
 E-12 Cast Iron Mon. in Mon. Box
 O.C. Remon. Nail & tag in S side PP N55°E 70.93'
 O.C. Remon. Nail & tag in E side PP S60°E 71.56'
 O.C. Remon. Nail & tag in E side PP S45°W 49.53'
 O.C. Remon. Nail & tag in S side PP N60°W 74.71'
 2' S of CL "X" 32nd Avenue and Sehler Street

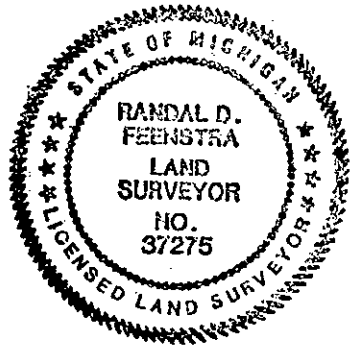

Signed by Randal D. Feentra Date May 9, 1994
 Surveyor's Michigan License No. 37275