

FEB 24 2000

OTTAWA COUNTY REMONUMENTATION

RECORDED

99 DEC -2 PM 1:14

SECTION

LAND CORNER RECORDATION CERTIFICATE
Filing Requirement of Act 74, Mich. P.A. 1970

Randy D. Feenstra
REGISTER OF DEEDS
OTTAWA COUNTY, MI

For corners in

<u>Ottawa</u> (County)	Located in:	Corner Code #
	Chester Twp.	
	9N 13W	F-1
1. Public Land Survey	T___ R___	N 1/4 Cor., Sec. 4
	T___ R___	_____
	T___ R___	_____
	T___ R___	_____
2. Property Controlling in Section	S___ T___ R___	_____
	S___ T___ R___	_____
3. Miscellaneous Property in Sec.	S___ T___ R___	_____
	S___ T___ R___	_____
4. Lot No. _____, Recorded Plat _____		
5. Private Claims _____		

Register of Deeds Stamp & File Number

I, Randal D. Feenstra, in a field survey on August 18, 1998 do hereby state that under requirements of P.A. 74, Michigan P.A. of 1970, the corner points mentioned in lines 1 and 2 above were in conformance with regulations and rules therefore as required in the current manual of survey instructions of the United States Department of the Interior, Bureau of Land Management or by a decree of a Court of Law and/or that the corner points mentioned in lines 3, 4 and 5 above were in conformance with the rules of the Michigan Board of Land Surveyors or by a Decree of a Court of Law, established, re-established, monumented, recovered, found as expressed below.

NOTE: Not more than 2 corners, all in the same town and range, may be recorded on this certificate.

A	B	C	D	E	F	G	H	I	J	K	L	M
1												
2	6	5	4	3	2	1						
3												
4	7	8	9	10	11	12						
5												
6	18	17	16	15	14	13						
7												
8	19	20	21	22	23	24						
9												
10	30	29	28	27	26	25						
11												
12	31	32	33	34	35	36						
13												

A. Description of original monument and accessories and/or subsequent restoration:
G.L.O. Not Set
Liber 3 Page 264 (1978) GLAZA
1/2" Iron Rod
1/2" Iron Rod (S1/4 cor. Sec. 33
T10N, R13) W 64.30'
Center 4" Tel. Box N65°W 79.50'
Nail in N side 20" Maple S80°E 373.20'

Liber 5, Page 359 (1988) WICKHAM
Rerod and Cap
Nail in SE side 6" Maple S70°W 68.35'
CL Top of MBT box N75°W 115.45'
in CL E-W Bit. Road

NOTE: Iron rod per Liber 3, Page 264 was held to perform surveys recorded in L-3, P-648/L-3, P-783/ and Liber, Page 784 by Glaza


B. Description of corner evidence found and/or method applied in restoring or reestablishing corner:
F-1 Found: 1/2" iron, 64.3' East of Muskegon Cor. Per L-3, P. 264
1/2" iron, 101.97' East of Muskegon Cor. Per L-5, P 359
Determined easterly iron set in wrong position (prorated wrong from G.L.O. information.
Held 1/2" iron, 64.3' East of Muskegon Cor.)

Witnesses found:
Center 4" Tel. Box N70°W 79.44'
1/2" iron rod (S1/4 cor., Sec. 33, T10N, R13W) W 64.30'

This position not established by original government surveyors. This location is accepted as the best available evidence of the position of the corner.

C. Description of monument for corner and accessories established to perpetuate locating the position of the corner:

F-1 Set Ottawa County Remon Bar and Cap in new monument box (on Town line)
Set Ottawa County Remon Tag & Nail in SE side 12" Poplar AZ 212°30' 30.74'
Top phone box 291°30' 79.44'
Set 1/2" iron rod 6.5' N of EBT 77°30' 78.42'
NW cor. house foundation 96°15' 407.52'
CL E/W Bit. Rd. (Sherman St.) S 0.8'
F-13 Muskegon Cor. (1/2" iron rod) W 64.3'

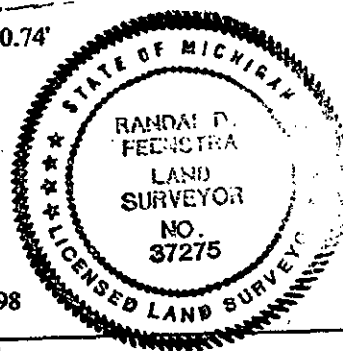

Receipt #64945

Signed by Randal D. Feenstra
Surveyor's Michigan License No. 37275

Date October 16, 1998

FEB 24 2000

SECTION

