

DEC 16 1996

COMMISSION

OTTAWA COUNTY REMONUMENTATION
LAND CORNER RECORDATION CERTIFICATE
Filing Requirement of Act 74, Mich. P.A. 1970

For corners in
Ottawa

(County)

Located In:

Corner Code ##

- 1. Public Land Survey T 9N R 13W F-5, S1/4 Cor.
T _____ R _____ Sec. 9
T _____ R _____ Chester Twp.
T _____ R _____
- 2. Property Controlling S _____ T _____ R _____
in Section S _____ T _____ R _____
- 3. Miscellaneous S _____ T _____ R _____
Property in Sec. S _____ T _____ R _____

- 4. Lot No. _____, Recorded Plat _____
- 5. Private Claims _____

I, Randal D. Feenstra, in a field survey on September 21, 1995, do hereby certify that under requirements of P.A. 74, Michigan P.A. of 1970, the corner points mentioned in lines 1 and 2 above were in conformance with regulations and rules therefore as required in the current manual of survey instructions of the United States Department of the Interior, Bureau of Land Management or by a decree of a Court of Law and/or that the corner points mentioned in lines 3, 4 and 5 above were in conformance with the rules of the Michigan Board of Land Surveyors or by a Decree of a Court of Law; established, re-established, monumented, re-monumented, recovered, found as expressed below:

NOTE: Not more than 4 corners, all in the same town and range, may be recorded on this certificate.

A. Description of original monument and accessories and/or subsequent restoration:

G.L.O. by Rasselas Whitcomb Sept. 17, 1838 POST 12" B. Ash N40°E 16 links 20" Elm S28°E 10 links	L-4, P-21, 1979 12" Maple N 26.57' 8" Maple NNE 35.97' 10" Ash SW 20.61'	L-4, P-237, 1981 C.I.M. 12" Maple N 26.61 10" Ash SW 20.61 8" Maple NNE 36.02 12" Maple SSE 54.27
--	---	--

B. Description of corner evidence found and/or method applied in restoring or reestablishing corner:

Found: 3/4 IRON in box
Nail in W side 14" Maple SSE 54.12


Accepted as a faithful perpetuation of the position of the original corner.

P.A. 345 OTTAWA COUNTY
PEER APPROVED 10-21-96

R. D. F.

C. Description of monument for corner and accessories established to perpetuate locating the position of the corner:

F-5 Set Ottawa County Remon. Bar and Cap in box	N10°W 47.07
Ottawa County Remon. Nail & Tag in E side 14" Oak	Maple S30°E 54.15'
Ottawa County Remon. Nail & Tag in W side 14"	S30°W 43.59'
Ottawa County Remon. Nail & Tag in E side 5" Elm	N50°E 66.62'
Ottawa County Remon. Nail & Tag in S. side 14" Beech	
0.5' N of centerline Hoover St.	

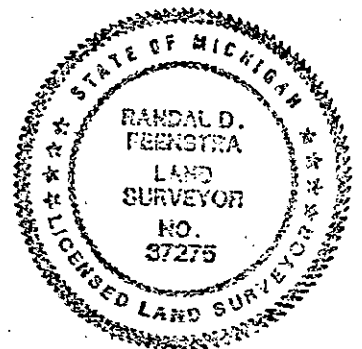

Signed by Randal D. Feenstra Date September 21, 1995

Surveyor's Michigan License No. 37275

RECORDED
96 NOV 14 AM 11:21
R. D. F.
REGISTER OF DEEDS
OTTAWA COUNTY, MI
Register of Deeds Stamp & File Number

