

SURVEY & REMONUMENTATION

APR 05 1996

OTTAWA COUNTY REMONUMENTATION

LAND CORNER RECORDATION CERTIFICATE
Filing Requirement of Act 74, Mich. P.A. 1970

COMMISSION

For corners in
Ottawa

(County)

Located In:	Chester Twp.	Corner Code #
	9N 13W	F-7, N 1/4 cor.
1. Public Land Survey	T ___ R ___	Sec. 21
	T ___ R ___	
	T ___ R ___	
	T ___ R ___	
2. Property Controlling in Section	S ___ T ___ R ___	
	S ___ T ___ R ___	
3. Miscellaneous Property in Sec.	S ___ T ___ R ___	
	S ___ T ___ R ___	

RECORDED

95 NOV 29 PM 1:41

Ralph D. Redwood
REGISTER OF DEEDS
OTTAWA COUNTY, MI

Register of Deeds Stamp & File Number

4. Lot No. _____, Recorded Plat _____
5. Private Claims _____

I, Randal D. Feenstra, in a field survey on Nov. 6, 1995 do hereby state that under requirements of P.A. 74, Michigan P.A. of 1970, the corner points mentioned in lines 1 and 2 above were in conformance with regulations and rules therefore as required in the current manual of survey instructions of the United States Department of the Interior, Bureau of Land Management or by a decree of a Court of Law and /or that the corner points mentioned in lines 3, 4 and 5 above were in conformance with the rules of the Michigan Board of Land Surveyors or by a Decree of a Court of Law; established, re-established, monumented, recovered, found as expressed below:

A	B	C	D	E	F	G	H	I	J	K	L	M
1												
2	6	5	4	3	2	1						
3												
4	7	8	9	10	11	12						
5												
6	18	17	16	15	14	13						
7												
8	19	20	21	22	23	24						
9												
10	30	29	28	27	26	25						
11												
12	31	32	33	34	35	36						
13												

NOTE: Not more than 2 corners, all in the same town and range, may be recorded on this certificate.

A. Description of original monument and accessories and/or subsequent restoration:

G.L.O. (1838)
Russelas Whitcomb
14" Beach South 28 lks.
14" B. Ash N8°E 41 lks

L-1, P-539, (1972)
5/8" Rod in Mon. Box
T. Pole S57.13'
8" Tw. Ash NE83.96'
8" Ash SE44.80'

L-4, P-335 (1982)
C.I.M.
Tele. Ped. N35.13'
10" Ash SE46.65'
P. Pole S57.20'
14" Tree NE88.16'

L-5, P-104 (1984)
1/2" Rod in Mon. Box
12" Boxelder NE88.18'
10" Quad Boxelder SE46.62'
18" Pine N68.43'

B. Description of corner evidence found and/or method applied in restoring or reestablishing corner:

Found: C.I.M. in box, No Cover Accepted as a careful and faithful perpetuation of the position of the original corner.

Nail in East side P. Pole S56.96'
Tele. Ped. N34.73'

P.A. 345 OTTAWA COUNTY


PEER APPROVED 11/20/95

Randal D. Feenstra
RP

C. Description of monument for corner and accessories established to perpetuate locating the position of the corner:

F-7 C.I.M. in box, No Cover
Ottawa County Remon Nail & Tag in E side P. Pole 177° 57.01'
Ottawa County Remon Nail & Tag in E side 12" Boxelder 359° 109.07'
NW cor. porch fndn. to Hse. #2768 120° 184.38'
SW cor. free standing garage to Hse. #2765 71° 239.67'
Tele. Ped 356° 34.73'

.5' North of centerline Gooding St. and 30' W of centerline Van Dyke St.

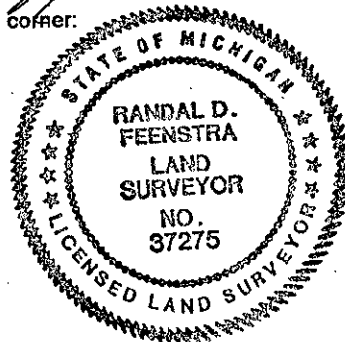

Signed by *Randal D. Feenstra*
Surveyor's Michigan License No. 37275

Date November 6, 1995