

SURVEY & REMONUMENTATION

APR 05 1996

COMMISSION

OTTAWA COUNTY REMONUMENTATION

LAND CORNER RECORDATION CERTIFICATE
Filing Requirement of Act 74, Mich. P.A. 1970

RECORDED
95 NOV 29 PM 1:36

D. J. ...
REGISTER OF DEEDS
OTTAWA COUNTY, MI

For corners in
Ottawa _____
(County)

Located in: Chester Twp. 9N 13W F-9, S 1/4 cor.
Corner Code # _____

1. Public Land Survey
T _____ R _____
T _____ R _____
T _____ R _____
T _____ R _____

2. Property Controlling in Section
S _____ T _____ R _____
S _____ T _____ R _____

3. Miscellaneous Property in Sec.
S _____ T _____ R _____

4. Lot No. _____, Recorded Plat _____
5. Private Claims _____

Register of Deeds Stamp & File Number

A	B	C	D	E	F	G	H	I	J	K	L	M
1												
2	6		5		4		3		2			1
3												
4	7		8		9		10		11			12
5												
6	18		17		16		15		14			13
7												
8	19		20		21		22		23			24
9												
10	30		29		28		27		26			25
11												
12	31		32		33		34		35			36
13												

I, Randal D. Feenstra, in a field survey on Nov. 6, 19 95 do hereby state that under requirements of P.A. 74, Michigan P.A. of 1970, the corner points mentioned in lines 1 and 2 above were in conformance with regulations and rules therefore as required in the current manual of survey instructions of the United States Department of the Interior, Bureau of Land Management or by a decree of a Court of Law and for that the corner points mentioned in lines 3, 4 and 5 above were in conformance with the rules of the Michigan Board of Land Surveyors or by a Decree of a Court of Law; established, re-established, monumented, recovered, found as expressed below:

NOTE: Not more than 2 corners, all in the same town and range, may be recorded on this certificate.

A. Description of original monument and accessories and/or subsequent restoration:


G.L.O. (1838) Russell's Whitcomb 30" Pine N45°E 11 lbs. 5" Beech S32°W 7 lbs	L-4, P-224 (1981) C.I.M. Pence N25.4' 9" Cherry NW34.27' 8" Cherry NNW26.45'	L-5, P-104 (1984) C.I.M. 10" W. Cherry NW34.21' 24" Maple WNW197.56' 4" W. Cherry NNW26.66'	L-6, P-220 (1992) Retod in Mon. Box 14" Pine N33°W 70.91' W. Cherry Clump N60°W 60.97' 6" W. Cherry N70°W 98.76' 6" Poplar N75°W 151.80' Capped Iron N 33.00'
---	--	---	---

B. Description of corner evidence found and/or method applied in restoring or reestablishing corner:

Found: 1/2" rebar. in Mon. box. Accepted as a careful and faithful perpetuation of the position of the original corner.

Nail in 6" Cherry N70°W 98.43'
Nail S side 6" Poplar N75°W 151.44'
Nail & Tag NE side 14" Pine N35°W 71.09'

P.A. 343 OTTAWA COUNTY
PEER APPROVED 11/20/95

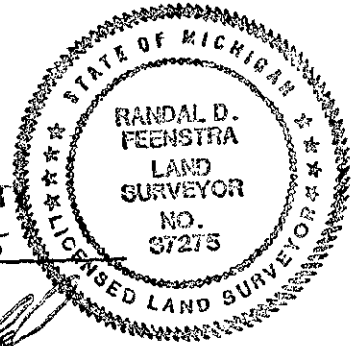

Randal D. Feenstra

C. Description of monument for corner and accessories established to perpetuate locating the position of the corner:

F-9 Set Ottawa County Rebar & Cap in Mon. Box S21°W 34.19'
Set Ottawa County Remon Nail & Tag in E side P. Pole N76°W 151.30'
Set Ottawa County Remon Nail & Tag in S side 6" Poplar N33°W 71.03'
Set Ottawa County Remon Nail & Tag NE side 14" Pine N54°E 43.40'
Set Ottawa County Remon Nail & Tag E end 15" C.M.P.

Centerline Coolidge St. (Bit. Road) 0.5'N

November 6, 1995

Signed by Randal D. Feenstra
Surveyor's Michigan License No. 37275

Date _____