

OCT 24 1994

COMMISSIONER

OTTAWA COUNTY REMONUMENTATION
 LAND CORNER RECORDATION CERTIFICATE
 Filing Requirement of Act 74, Mich. P.A. 1970

RECORDED

94 OCT -7 PM 12:34

Roger D. Hedwell
 REGISTER OF DEEDS
 OTTAWA COUNTY, MI

For corners in

Ottawa
 (County)

Located In:

Corner Code #/

- 1. Public Land Survey T 9N R 13W F-13, S 1/4
 T ___ R ___ Sec. 33, Chester
 T ___ R ___
 T ___ R ___
- 2. Property Controlling S ___ T ___ R ___
 in Section S ___ T ___ R ___
- 3. Miscellaneous S ___ T ___ R ___
 Property in Sec. S ___ T ___ R ___
- 4. Lot No. _____, Recorded Plat _____
- 5. Private Claims _____

Register of Deeds Stamp & File Number

	A	B	C	D	E	F	G	H	I	J	K	L	M
2	6	5	4	3	2	1							
3													
4	7	8	9	10	11	12							
5													
6	18	17	16	15	14	13							
7													
8	19	20	21	22	23	24							
9													
10	30	29	28	27	26	25							
11													
12	31	32	33	34	35	36							
13													

I, Randal D. Feenstra, in a field survey on May 9, 19 94, do hereby certify that under requirements of P.A. 74, Michigan P.A. of 1970, the corner points mentioned in lines 1 and 2 above were in conformance with regulations and rules therefore as required in the current manual of survey instructions of the United States Department of the Interior, Bureau of Land Management or by a decree of a Court of Law and/or that the corner points mentioned in lines 3, 4 and 5 above were in conformance with the rules of the Michigan Board of Land Surveyors or by a Decree of a Court of Law; established, re-established, monumented, re-monumented, recovered, found as expressed below:

NOTE: Not more than 4 corners, all in the same town and range, may be recorded on this certificate.

A. Description of original monument and accessories and/or subsequent restoration:

L.O. (1838) Liber 5, Page 210 (1984)
 or @ 10" Sugar Maple C.I.M.
 asseles Whitcomb Wright Twp Cor. E 57.66
 7" Ash SW 32.02
 16" Walnut SE 63.75
 18" Walnut NW 40.85

B. Description of corner evidence found and/or method applied in restoring or reestablishing corner:


Found: Cast Iron Mon. in Mon. Box - accepted as a careful and faithful perpetuation of the position of the original corner.

Found Witnesses:
 CIM, N 1/4 cor, Sec. 4, T8N, R13W E 57.70'

P.A. 345 OTTAWA COUNTY
 PEER APPROVED 8/22/24
Randal D. Feenstra

C. Description of monument for corner and accessories established to perpetuate locating the position of the corner:

F-13 Cast Iron Mon. in Mon. Box
 O.C. Remon. Nail & tag in S side PP N70°E 107.21'
 O.C. Remon. Nail & tag in N side 5" Pine S50°E 81.90'
 O.C. Remon. Nail & tag in E side 6" Twin Hickory S20°W 175.25'
 Wright Township Corner N90°E 57.70'
 1' West of CL Wilson and Tree Row to N.

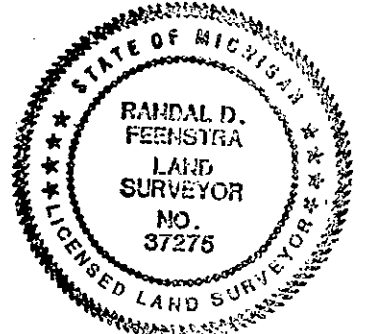

Signed by Randal D. Feenstra Date May 9, 1994
 Surveyor's Michigan License No. 37275