

SURVEY &
REMONUMENTATION

APR 05 1996

OTTAWA COUNTY REMONUMENTATION

COMMISSION

LAND CORNER RECORDATION CERTIFICATE
Filing Requirement of Act 74, Mich. P.A. 1970

For corners in
Ottawa
(County)

Located in: Corner Code #

1. Public Land Survey

Chester Twp.
9N 13W

G-7, NE cor.

Sec. 21

2. Property Controlling
in Section

T	R	
T	R	
T	R	
T	R	
S	T	R
S	T	R
S	T	R
S	T	R

3. Miscellaneous
Property in Sec.

4. Lot No. _____, Recorded Plat _____
5. Private Claims _____

RECORDED

95 NOV 29 PM 1:36

Ronald D. Feenstra
REGISTER OF DEEDS
OTTAWA COUNTY, MI

Register of Deeds Stamp & File Number

	A	B	C	D	E	F	G	H	I	J	K	L	M
1													
2	6		5		4		3		2		1		
3													
4	7		8		9		10		11		12		
5													
6	18		17		16		15		14		13		
7													
8	19		20		21		22		23		24		
9													
10	30		29		28		27		26		25		
11													
12	31		32		33		34		35		36		
13													

I, Randal D. Feenstra, in a field survey on Nov 6, 19 95 do hereby state that under requirements of P.A. 74, Michigan P.A. of 1970, the corner points mentioned in lines 1 and 2 above were in conformance with regulations and rules therefore as required in the current manual of survey instructions of the United States Department of the Interior, Bureau of Land Management or by a decree of a Court of Law and/or that the corner points mentioned in lines 3, 4 and 5 above were in conformance with the rules of the Michigan Board of Land Surveyors or by a Decree of a Court of Law; established, re-established, monumented, recovered, found as expressed below:

NOTE: Not more than 2 corners, all in the same town and range, may be recorded on this certificate.

A. Description of original monument and accessories and/or subsequent restoration:

G.L.O. (1838)
Russelas Whitcomb

5" Sugar S67°W 11 lks.
24" Beech N88°E 25 lks

L-1, P-535, (1972)

"T" Iron in Mon. Box
NE Cor. Town Hall SW 54.34'
Flag Pole NW 70.44'
P. Pole NE 56.17'
T. Pole SSE 49.72'

L-4, P-333 (1982)

C.I.M.
Stop Sign SE 38.43'
P. Pole NE 56.18'
T. Pole SW 49.70'
SE Cor. Hse. NW 88.86'

B. Description of corner evidence found and/or method applied in restoring or reestablishing corner:

Found: C.I.M. in box

Accepted as a careful and faithful perpetuation of the position of the original corner.

Nail in W side P. Pole

NE 56.18'
NW 88.82'

SE Fndn. Cor. to Hse. #2413

P.A. 345 OTTAWA COUNTY

PEER APPROVED 11/20/95

Ronald D. Feenstra
RDF

C. Description of monument for corner and accessories established to perpetuate locating the position of the corner:

G-7

C.I.M. in box

Ottawa County Remon Nail & Tag in W side P. Pole

24° 56.10'

Ottawa County Remon Nail & Tag in N side P. Pole

230° 49.47'


SE Fndn. Cor. to Hse. #2413

316° 88.82'

SW Fndn. Cor. to Hse. #2413

298° 128.51'

0.5' S of centerline Gooding St. and 24th Ave.

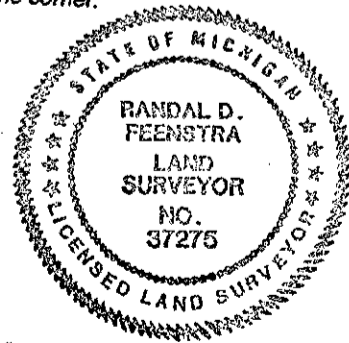

Signed by

Randal D. Feenstra

Date November 6, 1995

Surveyor's Michigan License No.

37275