

APR 05 1996

COMMISSION

OTTAWA COUNTY REMONUMENTATION

LAND CORNER RECORDATION CERTIFICATE
Filing Requirement of Act 74, Mich. P.A. 1970

For corners in
Ottawa

(County)

Located In: Corner Code #
Chester Twp. G-8, E 1/4 cor.
9N 13W
T___ R___ Sec. 21
T___ R___
T___ R___
T___ R___
S___ T___ R___
S___ T___ R___
S___ T___ R___
S___ T___ R___

1. Public Land Survey


2. Property Controlling
in Section

3. Miscellaneous
Property in Sec.

4. Lot No. _____, Recorded Plat _____
5. Private Claims _____

I, Randal D. Feenstra, in a field survey on Nov 6, 1995 do hereby state that under requirements of P.A. 74, Michigan P.A. of 1970, the corner points mentioned in lines 1 and 2 above were in conformance with regulations and rules therefore as required in the current manual of survey instructions of the United States Department of the Interior, Bureau of Land Management or by a decree of a Court of Law and for that the corner points mentioned in lines 3, 4 and 5 above were in conformance with the rules of the Michigan Board of Land Surveyors or by a Decree of a Court of Law; established, re-established, monumented, recovered, found as expressed below:

NOTE: Not more than 2 corners, all in the same town and range, may be recorded on this certificate.

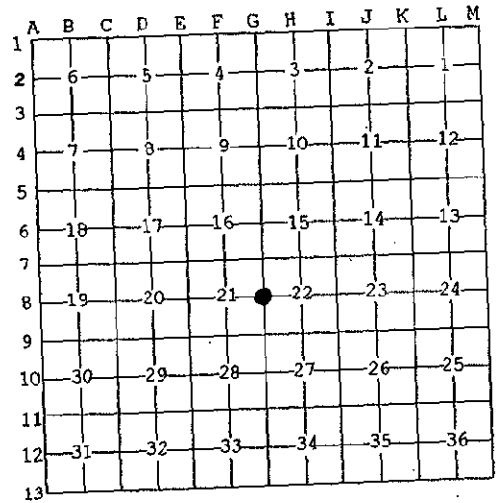

A. Description of original monument and accessories and/or subsequent restoration:

G.L.O. (1838) Russelas Whitcomb 24" Lynn N48°W 10 lks. 8" Beech S43°E 15 lks	L-5, P-104, (1964) Pk. Nail P. Pole SSW 178.33' P. Pole SSE 185.50' Pk. in W end only. W 28.65'	L-6, P-111 (1991) C.I.M. Chump W 61.78' Fence Post E 34.82' Fence Post SE 54.21' Fence Post. NE 59.96'	L-6, P-241 (1992) C.I.M. Fence Post N3°E 60.03' Fence Post East 34.85' Fence post S40°E 54.29' P. Pole S10°W 178.15'
---	---	---	---

P.A. 345 OTTAWA COUNTY
PEER APPROVED 11/20/95

B. Description of corner evidence found and/or method applied in restoring or reestablishing corner:

Found: C.I.M. in box Accepted as a careful and faithful perpetuation of the position of the original corner.

Nail in N. side wood fence post	36°	60.00'
Nail in N. side wood fence post	85°	34.83'
Nail in W side wood fence post	140°	54.16'
Pk & Tag in West side P. Pole	160°	185.40'

Handwritten signature: Randal D. Feenstra
Handwritten initials: R D F

C. Description of monument for corner and accessories established to perpetuate locating the position of the corner:

G-8 C.I.M. in box	36°	60.04'
Ottawa County Remon Nail & Tag in N side fence post	85°	34.87'
Ottawa County Remon Nail & Tag in N. side fence post	140°	54.19'
Ottawa County Remon nail & Tag in W side fence post	160°	185.40'
Ottawa County Remon. Nail & Tag in W side P. Pole		

on centerline 24th Ave. and treeline to West



Signed by Randal D. Feenstra
Surveyor's Michigan License No. 37275

Date November 6, 1995