

**SURVEY & REMONUMENTATION**

OCT 24 1994

COMMISSION

**OTTAWA COUNTY REMONUMENTATION  
LAND CORNER RECORDATION CERTIFICATE  
Filing Requirement of Act 74, Mich. P.A. 1970**

RECORDED

94 OCT -7 PM 12:34

*D. J. ...*  
REGISTER OF DEEDS  
OTTAWA COUNTY, MI

For corners in

Ottawa  
(County)

Located In:

Corner Code #

- 1. Public Land Survey T 9N R 13W G-12, E 1/4 COR  
T R Sec. 33, Chester  
T R  
T R
- 2. Property Controlling S T R  
in Section S T R
- 3. Miscellaneous S T R  
Property in Sec. S T R
- 4. Lot No. \_\_\_\_\_, Recorded Plat \_\_\_\_\_
- 5. Private Claims \_\_\_\_\_

Register of Deeds Stamp & File Number

	A	B	C	D	E	F	G	H	I	J	K	L	M
2	6	5	4	3	2	1							
3													
4	7	8	9	10	11	12							
5													
6	10	17	16	15	14	13							
7													
8	19	20	21	22	23	24							
9													
10	30	29	28	27	26	25							
11													
12	31	32	33	34	35	36							
13													

I, Randal D. Feenstra, in a field survey on May 9, 19 94, do hereby certify that under requirements of P.A. 74, Michigan P.A. of 1970, the corner points mentioned in lines 1 and 2 above were in conformance with regulations and rules therefore as required in the current manual of survey instructions of the United States Department of the Interior, Bureau of Land Management or by a decree of a Court of Law and/or that the corner points mentioned in lines 3, 4 and 5 above were in conformance with the rules of the Michigan Board of Land Surveyors or by a Decree of a Court of Law; established, re-established, monumented, re-monumented, recovered, found as expressed below:

**NOTE: Not more than 4 corners, all in the same town and range, may be recorded on this certificate.**

A. Description of original monument and accessories and/or subsequent restoration:  
G.L.O. (1838) Liber 6, Page 118 (1991)

- 14" Sugar S22°E 7.9' Cast Iron Mon.
- 18" Sugar N38°W 24.4' PP NNE 136.26
- POST CL Tel Ped. NW 55.75
- Rasselas Whitcomb PP SW 117.28
- 10" Ash SE 61.50

B. Description of corner evidence found and/or method applied in restoring or reestablishing corner:

Found: Cast Iron Mon. in Mon. Box - accepted as a careful and faithful perpetuation of the position of the original corner.

Found Witnesses:


- Nail in S side 10" Ash SE 61.49'
- Nail in E side PP SW 117.18'
- CL Telephone Ped. NW 55.66'

C. Description of monument for corner and accessories established to perpetuate locating the position of the corner:

- 3-12 Cast Iron Mon. in Mon. Box
- O.C. Remon. Nail & tag in W side PP N15°E 136.09'
- O.C. Remon: Nail & tag in NW side PP S45°W 117.19'
- O.C. Remon: Nail & tag in NW side 10" Ash S70°E 61.09'
- "X" in E end of 6' CSP N40°E 33.07'
- 4.5' E and 5' N of CL "X" 24th. Avneue and Sehler Street

PA. 345 OTTAWA COUNTY  
PEER APPROVED 8/22/94

*Gordon P. Nedwell*

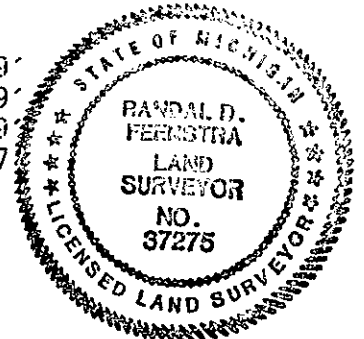

Signed by Randal D. Feenstra

Date May 9, 1994

Surveyor's Michigan License No. 37275