

SURVEY & REMONUMENTATION

NOV 10 1993

COMMISSION

LAND CORNER RECORDATION CERTIFICATE Filing Requirement of Act 74, Mich. P.A. 1970 OTTAWA COUNTY REMONUMENTATION

For corners in

OTTAWA
(County)

Located In:

Corner Code #

- | | | | | |
|---------------------------------------|-------------|--------------|-----|-----------------------------|
| 1. Public Land Survey | T <u>9N</u> | R <u>13W</u> | I-5 | NW Cor-14 |
| | T <u>9N</u> | R <u>13W</u> | | J-5, N $\frac{1}{4}$ Cor-14 |
| | T | R | | CHESTER TWP. |
| | T | R | | |
| 2. Property Controlling in Section | S | T | R | |
| | S | T | R | |
| 3. Miscellaneous Property in Sec. | S | T | R | |
| | S | T | R | |
| 4. Lot No. _____, Recorded Plat _____ | | | | |
| 5. Private Claims _____ | | | | |

RECORDED
1993 SEP 29 PM 3:14

Phyllis Johnson
REGISTER OF DEEDS
OTTAWA COUNTY, MI

Register of Deeds Stamp & File Number

I, Randal D. Feenstra in a field survey on July 20, 19 93, do hereby certify that under requirements of P.A. 74, Michigan P.A. of 1970, the corner points mentioned in lines 1 and 2 above were in conformance with regulations and rules therefore as required in the current manual of survey instructions of the United States Department of the Interior, Bureau of Land Management or by a decree of a Court of Law and/or that the corner points mentioned in lines 3, 4 and 5 above were in conformance with the rules of the Michigan Board of Land Surveyors or by a Decree of a Court of Law; established, re-established, monumented, re-monumented, recovered, found as expressed below:

	A	B	C	D	E	F	G	H	I	J	K	L	M
2	6	5	4	3	2	1							
3													
4	7	8	9	10	11	12							
5													
6	18	17	16	15	14	13							
7													
8	19	20	21	22	23	24							
9													
10	30	29	28	27	26	25							
11													
12	31	32	33	34	35	36							
13													

NOTE: Not more than 4 corners, all in the same town and range, may be recorded on this certificate.


A. Description of original monument and accessories and/or subsequent restoration:

- I-5 = LCRC#'s L-6, P-23; L-6, P-121.
- J-5 = LCRC#'s L-6, P-94.

B. Description of corner evidence found and/or method applied in restoring or reestablishing corner:

I-5
Found Cast Iron Monument
Per LCRC # L-6, P-121

J-5
Found Cast Iron Monument in Box
And Witnesses Per
LCRC # L-6, P-94

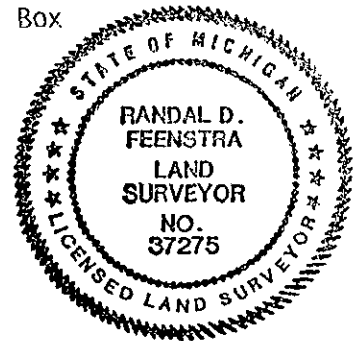

C. Description of monument for corner and accessories established to perpetuate locating the position of the corner:

- I-5-Cast Iron Monument per L-6, P-121, Ottawa County, MI, and is accepted as a careful and faithful perpetuation of the position of the original corner.
 - O.C. Remon. Nail & Tag in 8" Apple Tree N60°W 83.73
 - O.C. Remon. Nail & Tag in 8" Apple Tree N35°W 84.33
 - O.C. Remon. Nail & Tag in 10" Apple Tree N40°E 104.24
 - O.C. Remon. Nail & Tag in 10" Apple Tree N60°E 77.49
 - CL of 16th 0.5' W CL of Hoover 0' S
- J-5-Cast Iron Monument per L-6, P-94, Ottawa County, MI, and is accepted as a careful and faithful perpetuation of the position of the original corner.
 - O.C. Remon. Nail & Tag in fence post N10°E 41.23
 - CL MBT Pedestal S50°E 55.94
 - O.C. Remon. Nail & Tag in top of fence p. S5°W 46.88
 - "X" in North end of 16" CMP N65°W 81.26
 - CL of Hoover 0.5' South Fence line to South

Signed by Randal D. Feenstra

Date July 20, 1993

Surveyor's Michigan License No. 37275