

**SURVEY & REMONUMENTATION**

JUN 28 1999

**OTTAWA COUNTY REMONUMENTATION  
LAND CORNER RECORDATION CERTIFICATE  
Filing Requirement of Act 74, Mich. P.A. 1970**

98 NOV -4 PM 2:32

**SECTION**

For corners in

Ottawa (County)	Located In:	Corner Code #
	Chester Twp.	
1. Public Land Survey	T <u>9N</u> R <u>13W</u>	<u>1-6</u>
	T <u>   </u> R <u>   </u>	<u>E 1/4 Cor., Sec. 15</u>
	T <u>   </u> R <u>   </u>	<u>   </u>
	T <u>   </u> R <u>   </u>	<u>   </u>
2. Property Controlling in Section	S <u>   </u> T <u>   </u> R <u>   </u>	<u>   </u>
	S <u>   </u> T <u>   </u> R <u>   </u>	<u>   </u>
3. Miscellaneous Property in Sec.	S <u>   </u> T <u>   </u> R <u>   </u>	<u>   </u>
	S <u>   </u> T <u>   </u> R <u>   </u>	<u>   </u>

*[Signature]*  
REGISTER OF DEEDS  
OTTAWA COUNTY, MI

Register of Deeds Stamp & File Number

4. Lot No. \_\_\_\_\_, Recorded Plat \_\_\_\_\_  
5. Private Claims \_\_\_\_\_

I, Randal D. Feenstra, in a field survey on August 19, 19 98 do hereby state that under requirements of P.A. 74, Michigan P.A. of 1970, the corner points mentioned in lines 1 and 2 above were in conformance with regulations and rules therefore as required in the current manual of survey instructions of the United States Department of the Interior, Bureau of Land Management or by a decree of a Court of Law and /or that the corner points mentioned in lines 3, 4 and 5 above were in conformance with the rules of the Michigan Board of Land Surveyors or by a Decree of a Court of Law, established, re-established, monumented, recovered, found as expressed below.

NOTE: Not more than 2 corners, all in the same town and range, may be recorded on this certificate.

	A	B	C	D	E	F	G	H	I	J	K	L	M
1													
2	6		5		4		3		2		1		
3													
4	7		8		9		10		11		12		
5													
6	18		17		16		15		14		13		
7													
8	19		20		21		22		23		24		
9													
10	30		29		28		27		26		25		
11													
12	31		32		33		34		35		36		
13													

A. Description of original monument and accessories and/or subsequent restoration:

G.L.O. (1838) Rasselus Whitcomb 7" Water Beech N85°E 24 lks. 5" Dogwood S77°W 17 lks.	Tru-Line Witnesses 5/15/95 (NOTES, NOT RECORDED) PK Nail on CL Nail & Tag E side 8" Ash Clump (8' above gnd) SW 34.13 Nail & Tag E side 6" Ash (6' above gnd) SSW 58.87 Nail & Tag W side 8" Ash (7' above gnd) SE 37.08
--	--

B. Description of corner evidence found and/or method applied in restoring or reestablishing corner.

Found: Capped Rerod on line 1/2 way between I-5 & I-7


Found Nail & Tag W side 10" Ash (7' above gnd) AZ 128°20' 37.3'

Accepted as a careful and faithful perpetuation of the position of the original corner.

10/19/98  
*[Signature]*

C. Description of monument for corner and accessories established to perpetuate locating the position of the corner:

Set Ottawa County Remon Bar and Cap in new Monument Box  
Set Ottawa County Remon Nail & Tag in NW side 8" Ash (7' above gnd) AZ 26°40' 68.16'  
Set Ottawa County Remon Nail & Tag in SW side 10" Ash (7' above gnd) AZ 128°20' 37.36'  
Set Ottawa County Remon Nail & Tag in SE side 10" Ash (7' above gnd) AZ 210°40' 56.06'  
Set Ottawa County Remon Nail & Tag in N side 8" Ash (8' above gnd) AZ 264°15' 29.47'  
CL N-S Bit. Rd. (16th Ave.) 0.2'E  
Fence Row to West S 3'

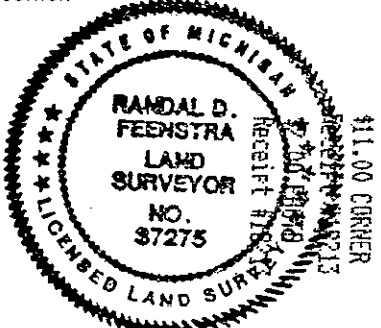

Signed by *Randal D. Feenstra* Date October 16, 1998  
Surveyor's Michigan License No. 37275

SURVEY &  
REMONUMENTATION

JUN 28 1999

SECTION

