

SURVEY & REMONUMENTATION

FEB 27 1998 OTTAWA COUNTY REMONUMENTATION

LAND CORNER RECORDATION CERTIFICATE
Filing Requirement of Act 74, Mich. P.A. 1970

SECTION

For corners in Ottawa (County) Located In: Chester Twp. Corner Code # J-1, N1/4 cor.

1. Public Land Survey T 9N R 13W Sec. 2

2. Property Controlling in Section S T R

3. Miscellaneous Property in Sec. S T R

4. Lot No. , Recorded Plat

5. Private Claims

RECORDED
97 DEC -8 AM 11:33

[Signature]
REGISTER OF DEEDS
OTTAWA COUNTY, MI

Register of Deeds Stamp & File Number

I, Randal D. Feenstra, in a field survey on Feb. 27, 1997 do hereby state that under requirements of P.A. 74, Michigan P.A. of 1970, the corner points mentioned in lines 1 and 2 above were in conformance with regulations and rules therefore as required in the current manual of survey instructions of the United States Department of the Interior, Bureau of Land Management or by a decree of a Court of Law and/or that the corner points mentioned in lines 3, 4 and 5 above were in conformance with the rules of the Michigan Board of Land Surveyors or by a Decree of a Court of Law; established, re-established, monumented, recovered, found as expressed below:

1	A	B	C	D	E	F	G	H	I	K	L	M
2		6	5			4		3		2		1
3												
4		7		8		9		10		11		12
5												
6		19		17		16		15		14		13
7												
8		19		20		21		22		23		24
9												
10		30		29		28		27		26		25
11												
12		31		32		33		34		35		36
13												

NOTE: Not more than 2 corners, all in the same town and range, may be recorded on this certificate.

A. Description of original monument and accessories and/or subsequent restoration:


G.L.O. L-4, P-264 (1981)
Not Set Set Cast Iron Monument
4" Dead Elm ENE 89.49'
3" Thornapple SE 50.60'
Tele. Pedestal S 41.35'
E End 12" Corr. Culvert NW 47.31'

B. Description of corner evidence found and/or method applied in restoring or reestablishing corner:

Found: Cast Iron Monument

Tele. Pedestal 41.35"
E end 12" Corr. Culvert NW 47.31'

P.A. 345 OTTAWA COUNTY
PEER APPROVED 11-17-97
[Signature]

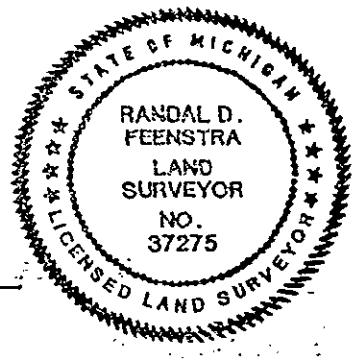

This position not established by original government surveyors. This monument is accepted as the best available evidence of the position of the corner.

C. Description of monument for corner and accessories established to perpetuate locating the position of the corner:

J-1 Set box around a found Cast Iron Monument (on townline to North, see sketch on back)


0.5' North of Centerline Sherman Blvd.
Found 1/2" Iron for Muskegon County Corner W. 80.09'
Tele. Pedestal S. 41.35'
Set Ottawa County Remon Nail & Tag in NE side 4" Thornapple N 65°W 77.90'
Set Ottawa County Remon Nail & Tag in NW side P. Pole S 67°E 231.40'
Set Ottawa County Remon Nail & Tag in NE side P. Pole S 60°E 168.10'

\$ 11.00 CORNER
\$ 2.00 PHOTO

Signed by Randal D. Feenstra
Surveyor's Michigan License No. 37275

Date February 27, 1997

MUSKEGON COUNTY
CASNOVIA TWP.

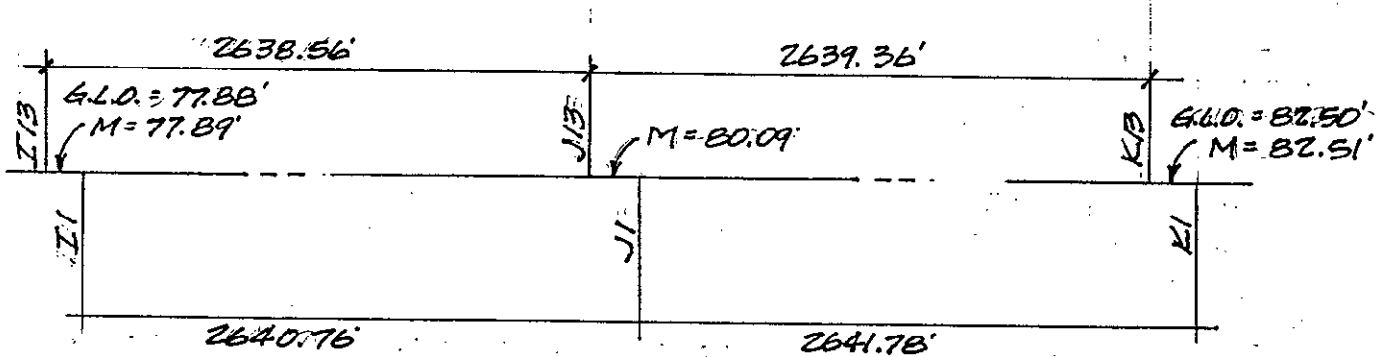

OTTAWA COUNTY
CHESTER TWP.

SURVEY &
REMONUMENTATION

FEB 27 1998

SECTION