

SURVEY & REMONUMENTATION

APR 24 1995

COMMISSION

OTTAWA COUNTY REMONUMENTATION LAND CORNER RECORDATION CERTIFICATE Filing Requirement of Act 74, Mich. P.A. 1970

RECORDED

94 DEC 15 AM 11:47

For corners in
Ottawa

(County)

Located In:

Corner Code ##

1. Public Land Survey	T <u>9N</u> R <u>13W</u>	J-3, N1/4 Cor.
	T _____ R _____	Sec. 11
	T _____ R _____	Chester Twp.
	T _____ R _____	
2. Property Controlling in Section	S _____ T _____ R _____	
	S _____ T _____ R _____	
3. Miscellaneous Property in Sec.	S _____ T _____ R _____	
	S _____ T _____ R _____	

Polycia Ballman
REGISTER OF DEEDS
OTTAWA COUNTY, MI

Register of Deeds Stamp & File Number

4. Lot No. _____, Recorded Plat _____
5. Private Claims _____

Randal D. Feenstra

December 8

94

I, _____, in a field survey on _____, 19____, do hereby certify that under requirements of P.A. 74, Michigan P.A. of 1970, the corner points mentioned in lines 1 and 2 above were in conformance with regulations and rules therefore as required in the current manual of survey instructions of the United States Department of the Interior, Bureau of Land Management or by a decree of a Court of Law and/or that the corner points mentioned in lines 3, 4 and 5 above were in conformance with the rules of the Michigan Board of Land Surveyors or by a Decree of a Court of Law; established, re-established, monumented, re-monumented, recovered, found as expressed below:

NOTE: Not more than 4 corners, all in the same town and range, may be recorded on this certificate.

	A	B	C	D	E	F	G	H	I	J	K	L	M
2	6	5	4	3	2	1							
3													
4	7	8	9	10	11	12							
5													
6	15	17	16	15	14	13							
7													
8	19	20	21	22	23	24							
9													
10	30	29	28	27	26	25							
11													
12	31	32	33	34	35	36							
13													

A. Description of original monument and accessories and/or subsequent restoration:
 G.L.O. by Rasselas Whitcomb L-2, P-519, 1974 L-5, P-46, 1983
 Sept. 17, 1838 Pipe in Mon. Box C.I.M.
 POST CL B.T. E-W P.P. SW 41.72
 12" Beech S85 W 20 links Fence - N-S 10" Apple N 44.05
 18" Beech N42 E 22 links SE Cor. Sch. Hse. 9" Maple S 41.39
 porch N24 W 131.62'
 P.P. S 44 W 41.68'
 Steel Fence Post S02 E 32.01'

B. Description of corner evidence found and/or method applied in restoring or reestablishing corner:
 Found C.I.M. in box (No cover) and is accepted as a careful and faithful perpetuation of the position of the original corner

Found Witnesses:

Steel Fence Post S 31.93'

SE Cor. School Hse. Porch NW 131.54'


P.A. 345 OTTAWA COUNTY

PEER APPROVED 12/12/94

Robert D. Hedewald

C. Description of monument for corner and accessories established to perpetuate locating the position of the corner:

J-3 C.I.M. in Box
 O.C. Remon Nail & Tag in NE side 4" Triple Cherry S30 E 45.64'
 O.C. Remon Nail & Tag in E side 16" Maple S5 E 41.76'
 "x" in W end 12" Con. Culv. N55 W 35.08'
 Capped "T" Iron N 00 E 32.89'
 On CL ~~Touman~~ Street and 170' W of Power Lines

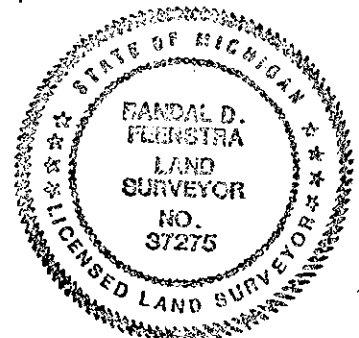

Randal D. Feenstra

Signed by Randal D. Feenstra

Date December 8, 1994

Surveyor's Michigan License No. 37275