

**SURVEY & REMONUMENTATION**

DEC 01 1998

SECTION

**OTTAWA COUNTY REMONUMENTATION  
LAND CORNER RECORDATION CERTIFICATE  
Filing Requirement of Act 74, Mich. P.A. 1970**

For corners in

<u>OTTAWA</u> (County)	Located In:	Corner Code #
1. Public Land Survey	T 9N R 13W	K-6, W 1/4 Corner, Sec 13, Chester Township
2. Property Controlling in Section	S T R	Seg. #2
3. Miscellaneous Property in Sec.	S T R	

**RECORDED**  
98 SEP 29 PM 1:56

*Randy Roberts*  
REGISTER OF DEEDS  
OTTAWA COUNTY, MI

Register of Deeds Stamp & File Number

4. Lot No. \_\_\_\_\_, Recorded Plat \_\_\_\_\_  
5. Private Claims \_\_\_\_\_

	A	B	C	D	E	F	G	H	I	J	K	L	M
1													
2	6	5	4	3	2	1							
3													
4	7	8	9	10	11	12							
5													
6	18	17	16	15	14	13							
7													
8	19	20	21	22	23	24							
9													
10	30	29	28	27	26	25							
11													
12	31	32	33	34	35	36							
13													

I, Randal J. Vugteveen, in a field survey on August 17, 1998 do hereby state that under requirements of P.A. 74, Michigan P.A. of 1970, the corner points mentioned in lines 1 and 2 above were in conformance with regulations and rules therefore as required in the current manual of survey instructions of the United States Department of the Interior, Bureau of Land Management or by a decree of a Court of Law and for that the corner points mentioned in lines 3, 4 and 5 above were in conformance with the rules of the Michigan Board of Land Surveyors or by a Decree of a Court of Law; established, re-established, monumented, recovered, found as expressed below:

NOTE: Not more than 2 corners, all in the same town and range, may be recorded on this certificate.

**A. Description of original monument and accessories and/or subsequent restoration:**

G.L.O. Whitcomb Sept 1838  
Set quarter sec. Post  
12" Beech S37°E 30 links  
10" Beech N77°W 30 links

Liber 6, Page 109  
Joiner 10-30-90  
Set C.I.M.  
1/2" Rod in Shoulder SW 38.04'  
P.P. E 166.95'  
P.P. NNW 159.78'

Remon Liber 1, Page 8  
K-6 C.I.M per L-6, P-109 at c.l 8th  
Remon Tag & Nail Fence Post S40°W 67.97'  
Remon Tag & Nail Fence Post N60°W 50.08'  
Remon Tag & Nail PF N10°W 159.33'  
Remon Tag & Nail PF N90°E 166.86'

**B. Description of corner evidence found and/or method applied in restoring or reestablishing corner:**

Fd Cast Iron Mon Broken off 1.5' below surface

Fd Nail and Remon Tag in S. Side P. Pole N90°E 166.93'

Accepted broken cast iron monument as a careful and faithful perpetuation of the position of the original corner

Set 3/4" X 18" Steel Bar with Ottawa Remon Cap on top of broken cast iron monument


9/21/98

**C. Description of monument for corner and accessories established to perpetuate locating the position of the corner:**

3/4" X 18" Steel Bar with Remon cap on top of Broken Cast Iron Monument

Set Nail and Remon Tag in E. side Power Pole N10°W 170.53'  
Found Nail and Remon Tag in NE cor RR Fence Post N55°W 50.07'  
Found Nail and Remon Tag in SE corner RR Fence Post S38°W 61.96'  
Found Nail and Remon Tag in S side P. Pole N90°E 166.93'

On Centerline Gravel Road to be Paved week of Aug 17th, 1998  
NOTE: This corner was reestablished as part of a road commission street improvement project.

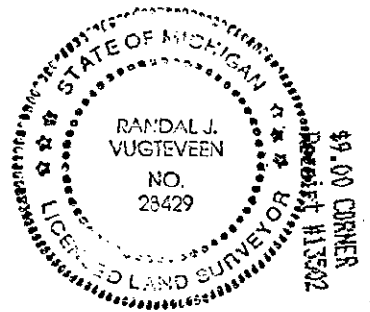

Signed by *Randal J. Vugteveen*  
Surveyor's Michigan License No. 28429

Date SEPT. 24, 1998