SURVEY &
REMONUMENTATION

NOV 1 0 1993

COMMISSION

LAND CORNER RECORDATION CERTIFICATE

Filing Requirement of Act 74, Mich. P.A. 1970

OTTAWA COUNTY REMONUMENTATION

RECORDED

1993 SEP 29 PM 3: 14

Phyllis Thelen
REGISTER OF DEEDS
OTTAWA COUNTY, MI

Register of Deeds Stamp & File Number

For corners in

OTTAWA
(County)

	Located In:	Corner Code #
1. Public Land Survey	CHESTER TWP. T 9N R 13W	K-7, SE Cor-14
	T ___ R ___	
	T ___ R ___	
	T ___ R ___	
2. Property Controlling	S ___ T ___ R ___	
in Section	S ___ T ___ R ___	
3. Miscellaneous	S ___ T ___ R ___	
Property in Sec.	S ___ T ___ R ___	

4. Lot No. _____, Recorded Plat _____
5. Private Claims _____

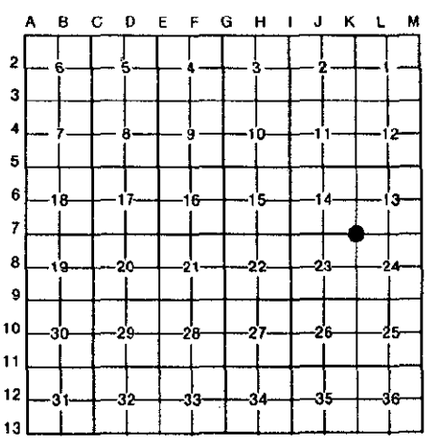

I, Randal D. Feenstra in a field survey on July 20, 19 93, do hereby certify that under requirements of P.A. 74, Michigan P.A. of 1970, the corner points mentioned in lines 1 and 2 above were in conformance with regulations and rules therefore as required in the current manual of survey instructions of the United States Department of the Interior, Bureau of Land Management or by a decree of a Court of Law and/or that the corner points mentioned in lines 3, 4 and 5 above were in conformance with the rules of the Michigan Board of Land Surveyors or by a Decree of a Court of Law; established, re-established, monumented, re-monumented, recovered, found as expressed below:

NOTE: Not more than 4 corners, all in the same town and range, may be recorded on this certificate.

A. Description of original monument and accessories and/or subsequent restoration:

K-7 = LCRC#'s L-5, P-238; L-6, P-109

B. Description of corner evidence found and/or method applied in restoring or reestablishing corner:

K-7

Found Cast Iron Monument In Box
And Witnesses Per
LCRC # L-6, P-109

STATE OF MICHIGAN
RANDAL D. FEENSTRA
LAND SURVEYOR
NO. 37275
LICENSED LAND SURVEYOR

C. Description of monument for corner and accessories established to perpetuate locating the position of the corner:

K-7-Cast Iron Monument per L-6, P-109, Ottawa County, MI, and is accepted as a careful and faithful perpetuation of the position of the original corner.

"X" in West end 16" corr. metal pipe	S25°W	56.58
O.C. Remon. Nail & Tag in cut-off P.P.	S50°E	67.02
"X" in North end 12" concrete culvert	N45°E	33.81
CL MBT box	N45°W	44.50

CL of Gooding _3'S., @ Cl 8th Ave.

Signed by Randal D. Feenstra Date July 20, 1993

Surveyor's Michigan License No. 37275

FORM APPROVED BY MICHIGAN STATE BOARD OF LAND SURVEYORS, JAN. 28, 1971
REVISED MAY 14, 1975
REVISED JAN., 1983