

SURVEY & REMONUMENTATION

NOV 10 1993

COMMISSION

LAND CORNER RECORDATION CERTIFICATE

Filing Requirement of Act 74, Mich. P.A. 1970

OTTAWA COUNTY REMONUMENTATION

RECORDED

1993 SEP 29 PM 3:14

For corners in

OTTAWA
(County)

Located In: _____ Corner Code: #

CHESTER TWP.

~~T 9N R 13W~~ **K-8, E 1/4 Cor-23**
~~T 9N R 13W~~ **I-9, SW Cor-23**
 T _____ R _____
 T _____ R _____
 S _____ T _____ R _____
 S _____ T _____ R _____
 S _____ T _____ R _____
 S _____ T _____ R _____

Phyllis G. Sullivan
 REGISTER OF DEEDS
 OTTAWA COUNTY, MI

Register of Deeds Stamp & File Number

1. Public Land Survey

2. Property Controlling in Section

3. Miscellaneous Property in Sec.

4. Lot No. _____, Recorded Plat _____

5. Private Claims _____

	A	B	C	D	E	F	G	H	I	J	K	L	M
2	6	5	4	3	2	1							
3													
4	7	8	9	10	11	12							
5													
6	18	17	16	15	14	13							
7													
8	19	20	21	22	23	24							
9													
10	30	29	28	27	26	25							
11													
12	31	32	33	34	35	36							
13													

I, Randal D. Feenstra in a field survey on July 20, 1993, do hereby certify that under requirements of P.A. 74, Michigan P.A. of 1970, the corner points mentioned in lines 1 and 2 above were in conformance with regulations and rules therefore as required in the current manual of survey instructions of the United States Department of the Interior, Bureau of Land Management or by a decree of a Court of Law and/or that the corner points mentioned in lines 3, 4 and 5 above were in conformance with the rules of the Michigan Board of Land Surveyors or by a Decree of a Court of Law; established, re-established, monumented, re-monumented, recovered, found as expressed below:

NOTE: Not more than 4 corners, all in the same town and range, may be recorded on this certificate.

A. Description of original monument and accessories and/or subsequent restoration:


K-8 = LCRC#'s L-5, P-238; L-6, P-79.

I-9 = LCRC#'s L-2, P-183; L-4, P-223.

B. Description of corner evidence found and/or method applied in restoring or reestablishing corner:

K-8
 Found Cast Iron Monument in Box
 And Witnesses Per _____
 LCRC # L-6, P-79

I-9
 Found Cast Iron Monument in Box
 And Witnesses Per _____
 LCRC # L-4, P-223

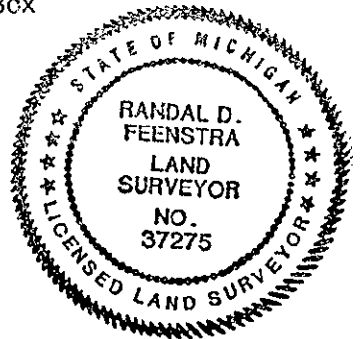

C. Description of monument for corner and accessories established to perpetuate locating the position of the corner:

-K-8-Cast Iron Monument per L-6, P-79, Ottawa County, MI, and is accepted as a careful and faithful perpetuation of the position of the original corner.
 O.C. Remon. Nail & Tag in Power Pole N85°E 41.60
 "X" in North end 12" Corr. Metal Pipe N80°W 26.02
 "X" in South end 12" Corr. Metal Pipe S45°W 34.58
 O.C. Remon. Nail & Tag in 30" Maple N40°E 114.72
 -I-9-Cast Iron Monument per L-4, P-223, Ottawa County, MI, and is accepted as a careful and faithful perpetuation of the position of the original corner.
 O.C. Remon. Nail & Tag in Power Pole N45°E 59.59
 O.C. Remon. Nail & Tag in Power Pole S55°W 89.58
 O.C. Remon. Nail & Tag in Power Pole N27°W 63.63
 "X" in S. end of 36" Corr. Metal Pipe S50°E 54.45

@CL "X" Coolidge & 16th

Signed by Randal D. Feenstra
 Surveyor's Michigan License No. 37275

Date July 20, 1993