

OCT 24 1994

COMMISSION

**OTTAWA COUNTY REMONUMENTATION
LAND CORNER RECORDATION CERTIFICATE
Filing Requirement of Act 74, Mich. P.A. 1970**

RECORDED

94 OCT -7 PM 12:34

Ralph D. Hollman
REGISTER OF DEEDS
OTTAWA COUNTY, MI

For corners in
Ottawa
(County)

Located In:

Corner Code #

- | | | | | | |
|------------------------------------|---|----|---|-----|------------------|
| 1. Public Land Survey | T | 9N | R | 13W | M-11, NE COR |
| | T | | R | | Sec. 36, Chester |
| | T | | R | | |
| | T | | R | | |
| 2. Property Controlling in Section | S | | T | | |
| | S | | T | | |
| 3. Miscellaneous Property in Sec. | S | | T | | |
| | S | | T | | |
4. Lot No. _____, Recorded Plat _____
5. Private Claims _____

Register of Deeds Stamp & File Number

	A	B	C	D	E	F	G	H	I	J	K	L	M
2	6	5	4	3	2	1							
3													
4	7	8	9	10	11	12							
5													
6	18	17	16	15	14	13							
7													
8	19	20	21	22	23	24							
9													
10	30	29	28	27	26	25							
11													
12	31	32	33	34	35	36							
13													

I, Randal D. Feenstra, in a field survey on July 13, 1994, do hereby certify that under requirements of P.A. 74, Michigan P.A. of 1970, the corner points mentioned in lines 1 and 2 above were in conformance with regulations and rules therefore as required in the current manual of survey instructions of the United States Department of the Interior, Bureau of Land Management or by a decree of a Court of Law and/or that the corner points mentioned in lines 3, 4 and 5 above were in conformance with the rules of the Michigan Board of Land Surveyors or by a Decree of a Court of Law; established, re-established, monumented, re-monumented, recovered, found as expressed below:

NOTE: Not more than 4 corners, all in the same town and range, may be recorded on this certificate.

A. Description of original monument and accessories and/or subsequent restoration:

<u>G.L.O. (1838)</u>	<u>Liber 3, Page 124 (1976)</u>	<u>Liber 5, Page 111 (1984)</u>
10" Beech N35°W 60.6'	RR Spike in Mon. Box	C.I.M. (Kent County)
9" Beech S51.5°W 14.5'	Pk. in T.P. NW 59.01	PP NE 64.00
POST	Pk. in PP NE 64.00	29" Maple NNW 77.15
Rasselas Whitcomb	CL St. Sign ENE 24.47	24" Maple WNW 83.15
		CL Street Sign SW 51.48

B. Description of corner evidence found and/or method applied in restoring or reestablishing corner:


Found: C.I.M. (Kent County) - accepted as a careful and faithful perpetuation of the position of the original corner.

Found Witnesses:
Pk in W side PP N25°E 63.89

P.A. 345 OTTAWA COUNTY
PEER APPROVED 9/22/94
Gordon P. Nedewell

C. Description of monument for corner and accessories established to perpetuate locating the position of the corner:

M-11 C.I.M. (Kent County)		
O.C. Remon: Nail & tag in NE side 32" Maple	N70°W	83.13
O.C. Remon: Nail & tag in SW side 30" Maple	N20°W	77.00
O.C. Remon: Nail & tag in S side PP	N25°E	63.40
O.C. Remon: Nail & tag in E side 8" Apple	S45°W	63.37
On CL "X" Harding Street and Kenowa Avenue		

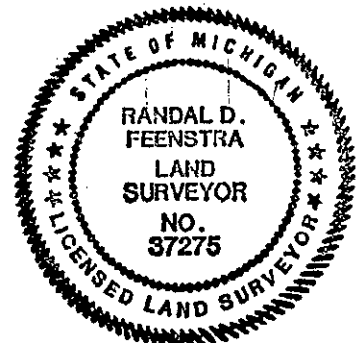

Signed by *Randal D. Feenstra* Date July 13, 1994

Surveyor's Michigan License No. 37275