

FEB 24 2000

RECORDED

SECTION

OTTAWA COUNTY REMONUMENTATION

99 DEC -2 PM 1:12

LAND CORNER RECORDATION CERTIFICATE
Filing Requirement of Act 74, Mich. P.A. 1970

Dany [Signature]
REGISTER OF DEEDS
OTTAWA COUNTY, MI

For corners in

OTTAWA

(County)

Located In:

Corner Code #

1. Public Land Survey

T9N R 13W

K-2 W 1/4 Corner

T R

Section 1, Chester

T R

Twp

T R

2. Property Controlling
in Section

S

T R

S

T R

3. Miscellaneous
Property in Sec.

S

T R

S

T R

Seg. 2

Register of Deeds Stamp & File Number

4. Lot No. _____, Recorded Plat _____

5. Private Claims _____

I, Randal J. Vugteveen, in a field survey on November 6, 1999 do hereby state that under requirements of P.A. 74, Michigan P.A. of 1970, the corner points mentioned in lines 1 and 2 above were in conformance with regulations and rules therefore as required in the current manual of survey instructions of the United States Department of the Interior, Bureau of Land Management or by a decree of a Court of Law and /or that the corner points mentioned in lines 3, 4 and 5 above were in conformance with the rules of the Michigan Board of Land Surveyors or by a Decree of a Court of Law, established, re-established, monumented, recovered, found as expressed below.

NOTE: Not more than 2 corners, all in the same town and range, may be recorded on this certificate.

	A	B	C	D	E	F	G	H	I	J	K	L	M
1													
2	6		5		4		3		2		▲	1	
3													
4	7		8		9		10		11		12		
5													
6	18		17		16		15		14		13		
7													
8	19		20		21		22		23		24		
9													
10	30		29		28		27		26		25		
11													
12	31		32		33		34		35		36		
13													

A. Description of original monument and accessories and/or subsequent restoration:

- K-2 Peer Approved Corner Liber 3, Page 256 (Feenstra September 16, 1996)
- K-2 Cast Iron Monument in Gravel Road
- Nail & Remon Tag in S side 8" Beech Az 313° 43.35'
- Nail & Remon Tag in E side 18" Ash Az 346° 86.20'
- Nail & Remon Tag in top fence post Az 23° 76.42'
- Nail & Remon Tag in N side 8" Cherry Az 75° 27.38'
- CL 8th Ave. (gravel) N & S 3.0' W

OTTAWA COUNTY
NOV 15 1999
[Signature]

B. Description of corner evidence found and/or method applied in restoring or reestablishing corner:

K-2 Found Cast Iron Monument

- Found Nail & Remon Tag S side 8" Beech N45°W 43.35'
- Found Nail & Remon Tag E side 18" Ash N15°W 86.20'
- Found Nail & Remon Tag Top fence post N25°E 76.42'
- Found Nail & Remon Tag N side 8" Cherry N75°E 27.38'


Accepted Cast Iron Monument as a careful and perpetuation of the position of the original corner.
Set Iron Witness outside of construction zone.

Set 3/4" X 24" Long Solid Bar with Ottawa County Remon Cap at intersection of witness ties.

C. Description of monument for corner and accessories established to perpetuate locating the position of the corner:

K-2 3/4" X 24" Long Solid Bar with Remon Cap

- Set Nail & Remon Tag in S side 10" Elm N84°E 50.16'
- Set Nail & Remon Tag in NE side 4" Elm N55°W 81.53'
- Set Nail & Remon Tag in Top of N end 12" CPP Culvert N27°W 56.01'
- Set Nail & Remon Tag in Top of S end 12" CPP Culvert S31°W 45.89'
- Iron Witness Point N46°E 72.71'
- Iron Witness Point S51°E 61.36'

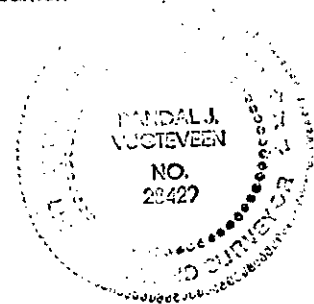

\$9.00 CORNER
Receipt #64945

Signed by

[Signature]

Date

Nov. 15, 1999

Surveyor's Michigan License No.

28429