

SURVEY & REMONUMENTATION

APR 25 1995

LAND CORNER RECORDATION CERTIFICATE

Filing Requirement of Act 74, Mich. P.A. 1970

For corners of **COMMISSION**

ONTONAGON
(County)

Located In:

Corner Code ##

- | | | | | | | |
|------------------------------------|---|------------|---|------------|------------|-------|
| 1. Public Land Survey | T | <u>46N</u> | R | <u>39W</u> | <u>G-3</u> | |
| | T | _____ | R | _____ | _____ | |
| | T | _____ | R | _____ | _____ | |
| | T | _____ | R | _____ | _____ | |
| 2. Property Controlling in Section | S | _____ | T | _____ | R | _____ |
| | S | _____ | T | _____ | R | _____ |
| 3. Miscellaneous Property in Sec. | S | _____ | T | _____ | R | _____ |
| | S | _____ | T | _____ | R | _____ |


APR 12 1995
1105
P
3
Judith Sheehan
186
REGISTER OF DEEDS

Register of Deeds Stamp & File Number

4. Lot No. _____, Recorded Plat _____
5. Private Claims _____

Section corner, Sections 3, 4, 9, 10; T46N., R39W.

I, Richard L. Drahn, in a field survey on June 17, 1993, do hereby certify that under requirements of P.A. 74, Michigan P.A. of 1970, the corner points mentioned in lines 1 and 2 above were in conformance with regulations and rules therefore as required in the current manual of survey instructions of the United States Department of the Interior, Bureau of Land Management or by a decree of a Court of Law and/or that the corner points mentioned in lines 3, 4 and 5 above were in conformance with the rules of the Michigan Board of Land Surveyors or by a Decree of a Court of Law; established, re-established, monumented, re-monumented, recovered, found as expressed below:

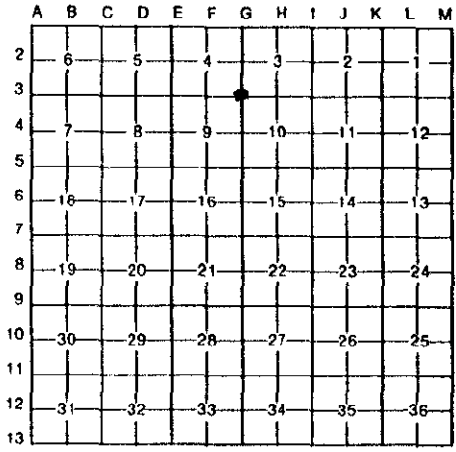

NOTE: Not more than 4 corners, all in the same town and range, may be recorded on this certificate.

A. Description of original monument and accessories and/or subsequent restoration:

Corner established by Zelotes B. Searls, U.S. Deputy Surveyor, on July 13, 1851.

Original bearing trees:

- | | | | | |
|----------|-----|---------|----------|--------------|
| Y. Birch | 20" | S.79°W. | 23 links | (15.18 feet) |
| Y. Birch | 10" | N.50°E. | 12 links | (7.92 feet) |

1½" iron pipe set by persons unknown.


B. Description of corner evidence found and/or method applied in restoring or reestablishing corner:

All original evidence destroyed by road construction. Corner found marked by a 1½" iron pipe in center line of old U.S. 45. Earl Applekamp, Land surveyor, from Ewen, Michigan, has used this pipe for many years. Vic Arcand, Surveyor in the 1940's, used this corner for surveying around the Paulding area. State Highway Plan shows corner in its present location. I accepted the 1½" pipe as being in the location that best represents the original corner location.

PEER GROUP

Approved

Earl W Applekamp 4-07-94
Ont. Co. Rep.

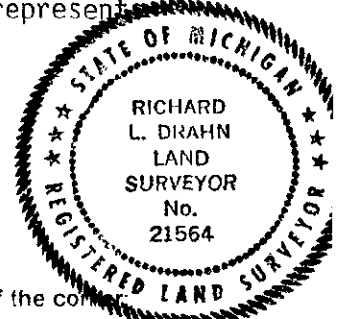

C. Description of monument for corner and accessories established to perpetuate locating the position of the corner:

At the corner position and 6" below surface of a East West & North county road I set a 3½" aluminum cap inside and on top of the 1½" iron pipe. Cap stamped to read: T46N., R39W.; S.3, S.4, S.9, S.10; 1993; R.L.S. 21564. From which I established the following new blazed and scribed bearing trees and reference objects.

- | | | |
|--|----------|------------|
| Bottom steps of concrete steps into Jarvi's Tavern | N.42°W., | 98.38 feet |
| Light Pole | N.73°E. | 94.32 feet |
| Wisconsin Michigan Power Co. Pole | S.21°W. | 88.19 feet |
| 6' steel sign posts | S.01°E. | 35.65 feet |

A standard 30" long, aluminum reference monument with a 3¼" aluminum cap, stamped to indicate true corner position bears South 35.55 feet.

Signed by Richard L. Drahn Date February 10, 1994
Surveyor's Michigan License No. 21564