

SURVEY & REMONUMENTATION

APR 25 1995

COMMISSION

LAND CORNER RECORDATION CERTIFICATE

Filing Requirement of Act 74, Mich. P.A. 1970

For corners in

ONTONAGON

(County)

Located In:

Corner Code #

- | | | |
|------------------------------------|---------------------------|------------|
| 1. Public Land Survey | T <u>46N</u> R <u>39W</u> | <u>I-4</u> |
| | T _____ R _____ | _____ |
| | T _____ R _____ | _____ |
| | T _____ R _____ | _____ |
| 2. Property Controlling in Section | S _____ T _____ R _____ | _____ |
| | S _____ T _____ R _____ | _____ |
| 3. Miscellaneous Property in Sec. | S _____ T _____ R _____ | _____ |
| | S _____ T _____ R _____ | _____ |

Recorded April 12 1994
 at 1:05 o'clock P.M. in
 Lib. 3 Page 188
Judith A. Drahn
 Register of Deeds

Register of Deeds Stamp & File Number

4. Lot No. _____, Recorded Plat _____
 5. Private Claims _____

$\frac{1}{4}$ Corner, Sections 10, 11; T46N., R39W.

I, Richard L. Drahn, in a field survey on June 29, 1993, do hereby certify that under requirements of P.A. 74, Michigan P.A. of 1970, the corner points mentioned in lines 1 and 2 above were in conformance with regulations and rules therefore as required in the current manual of survey instructions of the United States Department of the Interior, Bureau of Land Management or by a decree of a Court of Law and/or that the corner points mentioned in lines 3, 4 and 5 above were in conformance with the rules of the Michigan Board of Land Surveyors or by a Decree of a Court of Law; established, re-established, monumented, re-monumented, recovered, found as expressed below:

	A	B	C	D	E	F	G	H	I	J	K	L	M
2	6		5		4		3		2		1		
3													
4	7		8		9		10		11		12		
5													
6	18		17		16		15		14		13		
7													
8	19		20		21		22		23		24		
9													
10	30		29		28		27		26		25		
11													
12	31		32		33		34		35		36		
13													

NOTE: Not more than 4 corners, all in the same town and range, may be recorded on this certificate.

A. Description of original monument and accessories and/or subsequent restoration:

Corner established by Zelotes B. Searls, U.S. Deputy Surveyor, on July 16, 1851.
 Original bearing trees:

Y. Birch	6"	S.35°E.	13 links	(8.58 feet)
Fir	8"	N.24°W.	13 links	(8.58 feet)

2" diameter iron pipe set by Vic Arcand in 1948.

B. Description of corner evidence found and/or method applied in restoring or reestablishing corner:

No original corner or bearing trees found. Found 2" diameter iron pipe set by Vic Arcand, his unrecorded plat states corner was set by single proportion. I recovered Vic Arcand's iron pipe N.14°W., 109.55 feet from my proportioned point. I re-established the corner by single proportion measure on line between the N.W. and the S.W. corner of Section 11.

PEER GROUP

Approved

Richard L. Drahn


4/7/94

C. Description of monument for corner and accessories established to perpetuate locating the position of the corner:

At the corner position I set a standard 2" diameter by 30" long split base aluminum monument with a 3 1/4" aluminum cap stamped to read: T46N., R39W.; $\frac{1}{4}$; S.10, S.11; 1993; R.L.S. 21564: from which I established the following new blazed and scribed bearing trees and/or reference objects:

10"	Aspen	N.45°W.	8.29 feet
8"	Red Maple	N.76°E.	33.05 feet
8"	Red Maple	S.42°W.	11.28 feet

A 6' steel sign post bears: S.55°W., 1.15 feet.

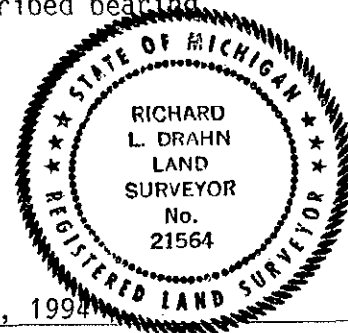

Signed by Richard L. Drahn

Date February 10, 1994

Surveyor's Michigan License No. 21564

U.S.F.S. G-17