SURVEY &
REMONUMENTATION

APR 2 5 1995

COMMISSION

LAND CORNER RECORDATION CERTIFICATE

Filing Requirement of Act 74, Mich. P.A. 1970

For corners in ONTONAGON (County)

	Located In:	Corner Code #
1. Public Land Survey	T 46N R 39W	J-3
	T ___ R ___	
	T ___ R ___	
	T ___ R ___	
2. Property Controlling	S ___ T ___ R ___	
in Section	S ___ T ___ R ___	
3. Miscellaneous	S ___ T ___ R ___	
Property in Sec.	S ___ T ___ R ___	

Recorded APRIL 12 89 94
at 1:05 o'clock P M. in
Liber 3 page 189
Judith D. Drahn
Register of Deeds

Register of Deeds Stamp & File Number

4. Lot No. _____ , Recorded Plat _____
5. Private Claims _____

¼ Corner, Sections 2 & 11; T.46N., R.39W.

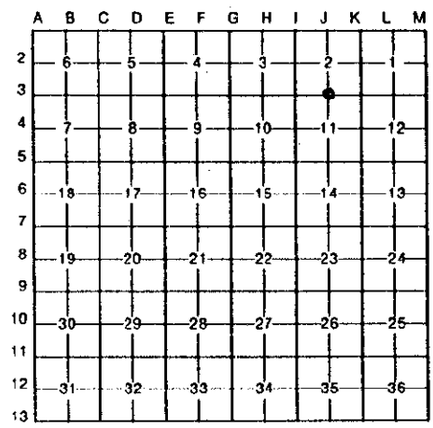

I, Richard L. Drahn in a field survey on July 22, 1993, do hereby certify that under requirements of P.A. 74, Michigan P.A. of 1970, the corner points mentioned in lines 1 and 2 above were in conformance with regulations and rules therefore as required in the current manual of survey instructions of the United States Department of the Interior, Bureau of Land Management or by a decree of a Court of Law and/or that the corner points mentioned in lines 3. 4 and 5 above were in conformance with the rules of the Michigan Board of Land Surveyors or by a Decree of a Court of Law; established, re-established, monumented, re-monumented, recovered, found as expressed below:

NOTE: Not more than 4 corners, all in the same town and range, may be recorded on this certificate.

A. Description of original monument and accessories and/or subsequent restoration:

Corner established by Zelotes B. Searls, U.S. Deputy Surveyor, on July 19, 1851.
Original bearing trees:

Sugar	18"	S.41°W.	18 links	(11.88 feet)
Hemlock	18"	N.43°E.	28 links	(18.48 feet)

B. Description of corner evidence found and/or method applied in restoring or reestablishing corner:

No evidence of original corner or bearing trees found. Corner re-established by single proportion measure on line between the N.E. and the N.W. corner of Section 11.

PEER GROUP **Approved**
Earl W Appelkamp 4-07-94

C. Description of monument for corner and accessories established to perpetuate locating the position of the corner:
At the corner position I set a standard 2" diameter by 30" long split base aluminum monument with a 3¼" aluminum cap stamped to read: T.46N., R.39W.; ¼; S.2, S.11; 1993; R.L.S. 21564: from which I established the following new blazed and scribed bearing trees and/or reference objects:

8"	Aspen	N.75°W.	9.50 feet
6"	White Birch	N.40°W.	4.38 feet
6"	Aspen	S.27°E.	10.64 feet

A 6' steel sign post bears: S.07°E., 2.10 feet

STATE OF MICHIGAN
RICHARD L. DRAHN LAND SURVEYOR No. 21564
REGISTERED LAND SURVEYOR

Signed by Richard L. Drahn Date February 10, 199

Surveyor's Michigan License No. 21564

U.S.F.S. E-19

FORM APPROVED BY MICHIGAN STATE BOARD OF LAND SURVEYORS, JAN. 28, 1971
REVISED MAY 14, 1975
REVISED JAN., 1983

189