

SURVEY & REMONUMENTATION

DEC 16 1996

COMMISSION

JUDITH D. ROEHM
 Ontonagon County
 LC 4/ 29 JEM Fee: 9.00
 03/04/96 15:27
 Page 1 of 1

LAND CORNER RECORDATION CERTIFICATE
 Filing Requirement of Act 74, Mich. P.A. 1970

For corners in

<u>Ontonagon</u> (County)	Located in:	Corner Code #
1. Public Land Survey	T <u>47</u> N. R. <u>38</u> W.	<u>E-6</u>
	T _____ R _____	_____
	T _____ R _____	_____
	T _____ R _____	_____
2. Property Controlling in Section	S _____ T _____ R _____	_____
	S _____ T _____ R _____	_____
3. Miscellaneous Property in Sec.	S _____ T _____ R _____	_____
	S _____ T _____ R _____	_____

Register of Deeds Stamp & File Number

4. Lot No. _____, Recorded Plat _____
 5. Private Claims _____

Quarter corner 16 & 17; T.47 N., R.38 W.

I, Richard L. Drahn, in a field survey on August 22, 19 95, do hereby certify that under requirements of P.A. 74, Michigan P.A. of 1970, the corner points mentioned in lines 1 and 2 above were in conformance with regulations and rules therefore as required in the current manual of survey instructions of the United States Department of the Interior, Bureau of Land Management or by a decree of a Court of Law and/or that the corner points mentioned in lines 3, 4 and 5 above were in conformance with the rules of the Michigan Board of Land Surveyors or by a Decree of a Court of Law; established, ~~re-established~~, monumented, re-monumented, recovered, found as expressed below:

	A	B	C	D	E	F	G	H	I	J	K	L	M
2	6	5	4	3	2								
3													
4	7	8	9	10	11	12							
5													
6	18	17	16	15	14	13							
7													
8	19	20	21	22	23	24							
9													
10	30	29	28	27	26	25							
11													
12	31	32	33	34	35	36							
13													

NOTE: Not more than 4 corners, all in the same town and range, may be recorded on this certificate.

A. Description of original monument and accessories and/or subsequent restoration:

Original corner established by Z. B. Searls, Deputy Surveyor on June 24, 1851.

Original bearing trees:

Hemlock	12"	S.29 W.	24 links	(15.84 feet)
Y. Birch	20"	N.05 E.	20 links	(13.20 feet)

Record research on file with Ontonagon County Representative.

B. Description of corner evidence found and/or method applied in restoring or reestablishing corner:

No evidence of original corner or bearing trees found. Corner position re-established by proportionate methods in a north-south gravel road and on line with fence lines east and west.


PEER GROUP APPROVED

Earl W. Applkauf
 COUNTY REPRESENTATIVE 1-17-96

C. Description of monument for corner and accessories established to perpetuate locating the position of the corner:

At the corner position and 6" below the surface of the N-S gravel road, I set a 2" dia. by 12" long iron pipe monument with a 3" dia. brass cap, stamped to read: T.47 N., R.38 W.; 1/4; S-16, S-17; 1995; R.L.S. 21564. From the monument I established the following bearing objects:

Stamped alum. Ref. Mon.	bears West	27.49 feet
Wi.-Mi. Power Pole # 77-1167	N.62 E.	33.42 feet
7" Basswood	S.53 E.	66.96 feet
6" Ash	S.59 W.	38.59 feet
6' Steel rail	West	28.79 feet

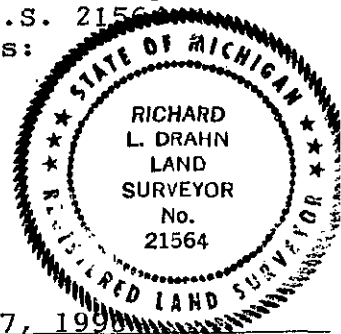

Signed by Richard L. Drahn Date January 17, 1996
 Surveyor's Michigan License No. 21564