

SURVEY & REMONUMENTATION

DEC 1 6 1996

COMMISSION

LAND CORNER RECORDATION CERTIFICATE
Filing Requirement of Act 74, Mich. P.A. 1970

JUDITH D. ROEHN
 Ontonagon County
 4/30 JEM Fee: 9.00
 03/04/96 15:27
 Page 1 of 1

For corners in

<u>Ontonagon</u> <small>(County)</small>	Located In:	Corner Code #
1. Public Land Survey	T <u>47N</u> R <u>38W</u>	<u>F-9</u>
	T _____ R _____	_____
	T _____ R _____	_____
	T _____ R _____	_____
2. Property Controlling in Section	S _____ T _____ R _____	_____
	S _____ T _____ R _____	_____
3. Miscellaneous Property in Sec.	S _____ T _____ R _____	_____
	S _____ T _____ R _____	_____
4. Lot No. _____, Recorded Plat _____		
5. Private Claims _____		

Register of Deeds Stamp & File Number

A	B	C	D	E	F	G	H	I	J	K	L	M
2	6	5	4	3	2	1						
3												
4	7	8	9	10	11	12						
5												
6	13	17	16	15	14	13						
7												
8	19	20	21	22	23	24						
9												
10	30	29	28	27	26	25						
11												
12	31	32	33	34	35	36						
13												

Quarter corner 21 & 28; T.47 N., R.38 W.

Richard L. Drahn in a field survey on July 27, 19 95, do hereby certify that under requirements of P.A. 74, Michigan P.A. of 1970, the corner points mentioned in lines 1 and 2 above were in conformance with regulations and rules therefore as required in the current manual of survey instructions of the United States Department of the Interior, Bureau of Land Management or by a decree of a Court of Law and/or that the corner points mentioned in lines 3, 4 and 5 above were in conformance with the rules of the Michigan Board of Land Surveyors or by a Decree of a Court of Law; established, re-established, monumented, re-monumented, recovered, found as expressed below:

NOTE: Not more than 4 corners, all in the same town and range, may be recorded on this certificate.

A. Description of original monument and accessories and/or subsequent restoration:

Original corner established by Z.B. Searls, Deputy Surveyor on June 24, 1851.

Original bearing trees:

Sugar	18"	S.70 W.	11 links	(7.26 feet)
Sugar	18"	N.30 E.	26 links	(17.16 feet)

Record research on file with Ontonagon County Representative.

B. Description of corner evidence found and/or method applied in restoring or reestablishing corner:

No evidence of original corner or bearing trees found. Corner position re-established on line between and equal distance from the northeast and northwest section corners of section 28; T.47 N., R.38 W. East-west fence line through corner area.


PEER GROUP APPROVED

Paul W. Goldkamp
 COUNTY REPRESENTATIVE 1-17-96

C. Description of monument for corner and accessories established to perpetuate locating the position of the corner:

At the corner position I set a 2½" diameter by 30" long aluminum monument with a ¾" aluminum cap, stamped to read: T.47 N., R.38 W.; ¼; S-21, S-28; 1995; R.L.S. 21564. From which I established the following new blazed and scribed bearing trees:

5"	Red Maple	N.58 W.	14.90 feet
11"	Sugar Maple	N.75 E.	14.42 feet
4"	Sugar Maple	S.21 E.	22.04 feet
6"	Steel rail	S.03 W.	1.55 feet

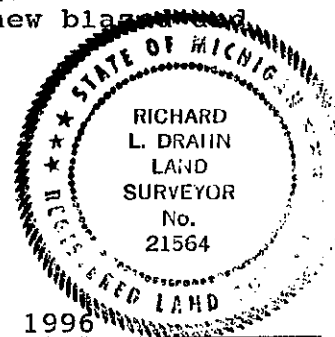

Signed by Richard L. Drahn

Date January 17, 1996

Surveyor's Michigan License No. 21564