


LAND CORNER RECORDATION CERTIFICATE
Filing Requirement of Act 74, Mich. P.A. 1970
Ontonagon County Remonumentation Corner

Ontonagon County
LC 5/119
Rec. Date 08/03/98 Time 09:18
RECORDING FEE: 9.00

For corners in

Table with columns: Ontonagon County, Located in:, Corner Code #. Rows include Public Land Survey, Property Controlling in Section, Miscellaneous Property in Sec., Lot No., and Private Claims.

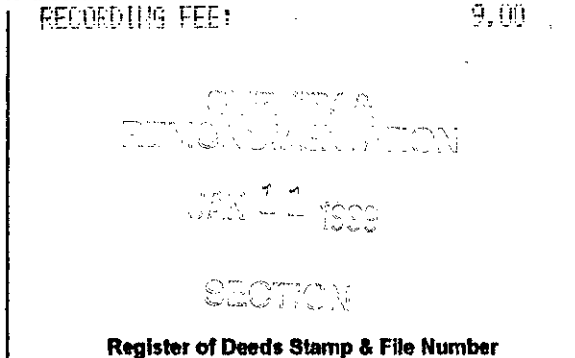

I, Joseph C. Domitrovich, in a field survey on July 21, 1998, do hereby state that under requirements of P.A. 74, Michigan P.A. of 1970, the corner points mentioned in lines 1 and 2 above were in conformance with regulations and rules therefore as required in the current manual of survey instructions of the United States Department of the Interior, Bureau of Land Management or by a decree of a Court of Law and /or that the corner points mentioned in lines 3, 4 and 5 above were in conformance with the rules of the Michigan Board of Land Surveyors or by a Decree of a Court of Law; established, re-established, monumented, recovered, found as expressed below:

NOTE: Not more than 2 corners, all in the same town and range, may be recorded on this certificate.

A. Description of original monument and accessories and/or subsequent restoration:

(I-2) 1/4 Corner Common to Sections 2 & 3, T47N, R38W

- 1851 - Zelotes B. Searls set a post
4" Hemlock S 35° E 13 links
10" Fir N 37° W 15 links

I found no subsequent record.

B. Description of corner evidence found and/or method applied in restoring or reestablishing corner:

I found no remains of the original corner or accessories. A North-South gravel road now runs over the area of the Corner, and an old fenceline runs West from area of the Corner.

I created a position for the Corner at a proportionate distance between Section Corners to the North and South and held the centerline of the gravel road for the East-West position. This position works well with the fenceline to the West. I accepted this position as the 1/4 Corner and have monumented it as such.

Research on file with County Remonumentation Representative.


PEER GROUP APPROVED
Paul W. Applekamp
COUNTY REGISTER OF DEEDS 7-22-98

C. Description of monument for corner and accessories established to perpetuate locating the position of the corner:

Corner is a 5/8" x 24" iron pin with a 3" diameter aluminum cap stamped to read: COUNTY REMONUMENTATION; T.47N, R.38W; 1/4; S.3, S.2; 1998; P.S. 37273. I also established a reference monument (R.M.) to the Southeast, a 3/4" x 36" aluminum rod with a 3" diameter aluminum cap stamped to indicate that the 1/4 Corner is N 26° W a distance of 51.10 feet.

Witnesses:

Table with columns: Witness, Bearing, Distance. Includes Power Pole, R.M., 4" Twin Apple, 1/2" Iron # 37273, NE Cor. Section 3, SE Cor. Section 3.

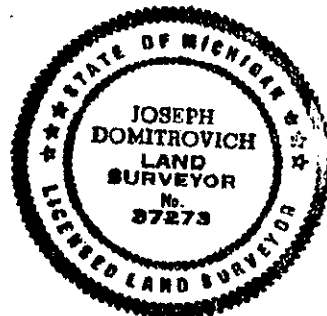

NOTE: Bearings to witness objects are magnetic. Distances are to a nail in side of the witness object unless noted.

Signed by J.C. Domitrovich

Date 7/22/98

Surveyor's Michigan License No. 37273