

DEC 16 1996

**COMMISSION**

JUDITH D. ROEHM  
 Ontonagon County  
 LC 4/ 32 JEM Fee: 9.00  
 Page 1 of 1  
 03/04/96  
 15:28

**LAND CORNER RECORDATION CERTIFICATE**  
**Filing Requirement of Act 74, Mich. P.A. 1970**

For corners in

<u>Ontonagon</u> (County)	Located In:	Corner Code <del>##</del>
1. Public Land Survey	T <u>47N.</u> R <u>38W.</u>	<u>I-6</u>
	T _____ R _____	_____
	T _____ R _____	_____
	T _____ R _____	_____
2. Property Controlling in Section	S _____ T _____ R _____	_____
	S _____ T _____ R _____	_____
3. Miscellaneous Property in Sec.	S _____ T _____ R _____	_____
	S _____ T _____ R _____	_____
4. Lot No. _____, Recorded Plat _____		
5. Private Claims _____		

Register of Deeds Stamp & File Number

Quarter corner 14 & 15; T.47 N., R.38 W.

I, Richard L. Drahn in a field survey on August 22, 19 95, do hereby certify that under requirements of P.A. 74, Michigan P.A. of 1970, the corner points mentioned in lines 1 and 2 above were in conformance with regulations and rules therefore as required in the current manual of survey instructions of the United States Department of the Interior, Bureau of Land Management or by a decree of a Court of Law and/or that the corner points mentioned in lines 3, 4 and 5 above were in conformance with the rules of the Michigan Board of Land Surveyors or by a Decree of a Court of Law; established, re-established, monumented, re-monumented, recovered, found as expressed below:

	A	B	C	D	E	F	G	H	I	J	K	L	M
2	6	5	4	3	2	1							
3													
4	7	8	9	10	11	12							
5													
6	18	17	16	15	14	13							
7													
8	19	20	21	22	23	24							
9													
10	30	29	28	27	26	25							
11													
12	31	32	33	34	35	36							
13													

**NOTE: Not more than 4 corners, all in the same town and range, may be recorded on this certificate.**

**A. Description of original monument and accessories and/or subsequent restoration:**

Original corner established by Z.B. Searls, Deputy Surveyor on June 19, 1851. Original bearing trees: --- W. Pine 18" S.31 E. 16 links (10.56 feet) --- Spruce 16" N.65 W. 14 links (9.24 feet) ---

Richard L. Drahn, R.L.S. 21564, on 8/10/81, re-monumented this corner from: local testimony; a recovered iron pin set in 1959; occupational lines of long standing and natural feature ties. Corner recorded on 6/15/82 in Liber 2, Page 37 of Ontonagon Counties Corner records.

**B. Description of corner evidence found and/or method applied in restoring or reestablishing corner:**

Original corner and bearing trees destroyed by road construction. Recent reconstruction of the county road has destroyed the sub-surface monument and the three bearing objects. Corner position re-monumented from the 1981 Reference Monument and the steel rail.  
 2" by 5' iron pipe Ref. Mon. w/ 3" stamped brass cap West 21.96'.  
 Metal sign post bears West 23.0 feet.


Act 74 research on file with Ontonagon County Representative.

PEER GROUP APPROVED

*Earl W. Applekamp*  
 COUNTY REPRESENTATIVE 1-17-96

**C. Description of monument for corner and accessories established to perpetuate locating the position of the corner:**

At the corner position on the center of the north-south road and slightly below the surface of the blacktop, I set a 3" diameter brass cap, stamped to read: T.47 N., R.38 W.; ¼; S-14, S-15; 1995; R.L.S. 21564. From which I established the following new bearing objects:  
 LSWP Power Pole #356 N.43 E. 58.57'  
 1981 Reference Monument West 21.96 feet  
 Metal sign post bears West 23.0 feet  
 8" Cedar S.67 E. 54.31 feet  
 3" W. Pine S.74 W. 30.43 feet

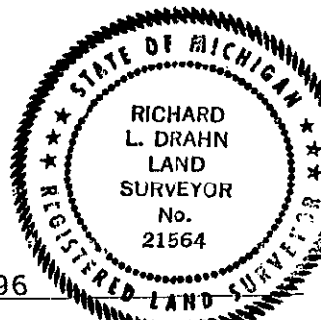

Signed by Richard L. Drahn

Date January 17, 1996

Surveyor's Michigan License No. 21564