


JUDITH D. ROEHM  
**LAND CORNER RECORDATION CERTIFICATE** (Ontonagon County)  
**Filing Requirement of Act 74, Mich. P.A. 1970 of 1** LC 5-122  
**Ontonagon County Remonumentation Corner** REC. Date 08/03/98 Time 09:20  
 RECORDATION FEE: 9.00

For corners in

Ontonagon County	Located in:	Corner Code #
1. Public Land Survey	T47N R38W	J-5
	T R	
	T R	
	T R	
2. Property Controlling in Section	S T R	
	S T R	
3. Miscellaneous Property in Sec.	S T R	
	S T R	
4. Lot No.	Recorded Plat	
5. Private Claims		

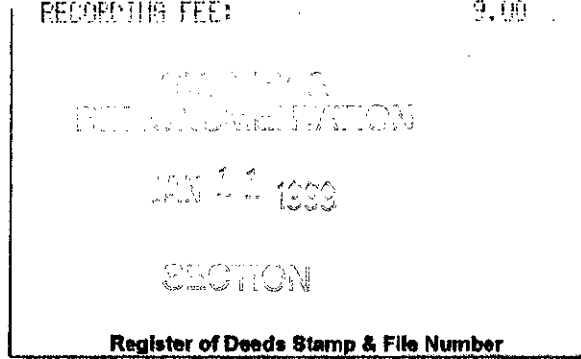

I, Joseph C. Domitrovich, in a field survey on July 21, 1998, do hereby state that under requirements of P.A. 74, Michigan P.A. of 1970, the corner points mentioned in lines 1 and 2 above were in conformance with regulations and rules therefore as required in the current manual of survey instructions of the United States Department of the Interior, Bureau of Land Management or by a decree of a Court of Law and /or that the corner points mentioned in lines 3, 4 and 5 above were in conformance with the rules of the Michigan Board of Land Surveyors or by a Decree of a Court of Law; established, re-established, monumented, recovered, found as expressed below:

NOTE: Not more than 2 corners, all in the same town and range, may be recorded on this certificate.

A. Description of original monument and accessories and/or subsequent restoration:  
(J-5) 1/4 Corner Common to Section 11 & 14, T47N, R38W

1851 - Zelotes B. Searls set a post  
 10" Cedar S 50° W 19 links  
 18" White Pine N 47° E 17 links

1958 - M.S.H.D., for M-28 Highway plans, shows this corner but does not say what it is.  
 Ties: Power Pole N 75° E 94.31'  
 6" Birch S 83° W 32.56'  
 8" Twin Maple N 61° W 45.60'

PEER GROUP APPROVAL  
*Earl W. Applekamp*  
 COUNTY REPRESENTATIVE  
 7-22-98

B. Description of corner evidence found and/or method applied in restoring or reestablishing corner:


I found no remains of the original corner or accessories. I also found no remains of M.S.H. D. corner or ties. An East-West gravel road now runs over the area of the Corner. I found a 5/8" iron pin on the South edge of the gravel road. This iron pin set by an unknown surveyor appears to have been re-established by single proportionate measurement. It works well with other corners in the area. I accepted the 5/8" iron as the 1/4 Corner and placed an aluminum cap on it.

Research on file with County Remonumentation Representative.

C. Description of monument for corner and accessories established to perpetuate locating the position of the corner:

Corner is a 5/8" iron pin with a 3" diameter aluminum cap stamped to read: COUNTY REMONUMENTATION; 1998; 1/4; S.11, S.14; T.47N, R.38W; P.S. 37273. I also established a Reference Monument (R.M.) to the North, stamped to indicate that the Corner is South a distance of 28.93 feet. Corner falls 8 feet South of centerline of gravel road.

Witnesses:  
 Power Pole N 72° E 116.30'  
 8" Twin W. Birch S 52° E 46.96'  
 14" Red Pine S 13° E 38.64'  
 6" Apple Tree N 41° W 78.18'  
 R.M. North 28.93'  
 SW Cor. Section 11 S 89° 46' 58" W 2640.89'  
 SE Cor. Section 11 N 89° 47' 00" E 2640.80'

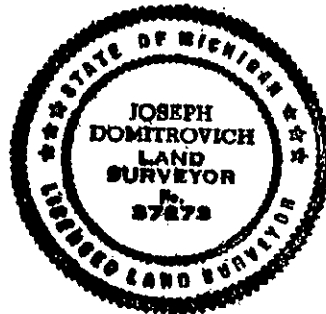

NOTE: Bearings to witness objects are magnetic. Distances are to a nail in side of the witness object unless noted.

Signed by Joseph C. Domitrovich

Date 7/22/98

Surveyor's Michigan License No. 37273