

DEC 16 1996

COMMISSION

JUDITH D. ROEHM  
Ontonagon County  
LC 4/34 JEM Fee: 9.00  
Page 1 of 1

LAND CORNER RECORDATION CERTIFICATE  
Filing Requirement of Act 74, Mich. P.A. 1970

For corners in

<u>Ontonagon</u> (County)	Located In:	Corner Code ##
1. Public Land Survey	T <u>47N</u> R <u>38 W.</u>	<u>J-7</u>
	T _____ R _____	_____
	T _____ R _____	_____
	T _____ R _____	_____
2. Property Controlling in Section	S _____ T _____ R _____	_____
	S _____ T _____ R _____	_____
3. Miscellaneous Property in Sec.	S _____ T _____ R _____	_____
	S _____ T _____ R _____	_____

Register of Deeds Stamp & File Number

4. Lot No. \_\_\_\_\_, Recorded Plat \_\_\_\_\_  
5. Private Claims \_\_\_\_\_

Quarter corner 14 & 23; T.47 N., R.38 W.

I, Richard L. Drahn, in a field survey on August 18, 19 95, do hereby certify that under requirements of P.A. 74, Michigan P.A. of 1970, the corner points mentioned in lines 1 and 2 above were in conformance with regulations and rules therefore as required in the current manual of survey instructions of the United States Department of the Interior, Bureau of Land Management or by a decree of a Court of Law and/or that the corner points mentioned in lines 3, 4 and 5 above were in conformance with the rules of the Michigan Board of Land Surveyors or by a Decree of a Court of Law; established, ~~re-established~~, monumented, re-monumented, recovered, found as expressed below:

	A	B	C	D	E	F	G	H	I	J	K	L	M
2	6		5		4		3		2		1		
3													
4	7		8		9		10		11		12		
5													
6	18		17		16		15		14		13		
7													
8	19		20		21		22		23		24		
9													
10	30		29		28		27		26		25		
11													
12	31		32		33		34		35		36		
13													

NOTE: Not more than 4 corners, all in the same town and range, may be recorded on this certificate.

A. Description of original monument and accessories and/or subsequent restoration:  
Original corner established by Z. B. Searls, Deputy Surveyor on June 16, 1851.  
Original bearing trees:  
Spruce 18" S.69 E. 13 links (8.58 feet)  
Cedar 12" N.52 W. 19 links (12.54 feet)


Record research of file with Ontonagon County Representative.

B. Description of corner evidence found and/or method applied in restoring or reestablishing corner:  
No evidence of original corner or bearing trees found. Corner position re-established near mathematical location on the centerline of an east-west county road and on line with old fence lines north and south.

PEER GROUP APPROVED  
*Earl W. Apalke*  
COUNTY REPRESENTATIVE 1-17-96

C. Description of monument for corner and accessories established to perpetuate locating the position of the corner:  
At the corner location and 6" below the centerline of the E-W County Road, I set a 2" dia. by 18" long iron pipe with a 3" brass cap stamped to read: T.47 N., R.38 W.; ¼; S-14, S-23; 1995; R.L.S. 21564. From which I established the following:

Stamped alum.	Ref. Mon.	bears	South	33.05 feet
6"	Aspen	N.13 E.	44.40 feet	
3"	Aspen	S.40 E.	58.29 feet	
4"	Red Pine	S.07 W.	52.40 feet	
6'	Steel rail	South	34.17 feet	

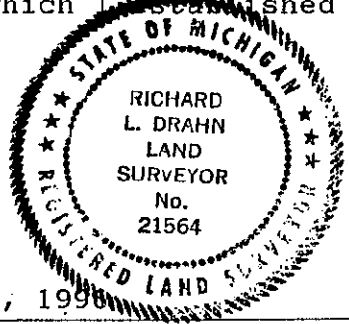

Signed by Richard L. Drahn Date January 17, 1996  
Surveyor's Michigan License No. 21564