

DEC 16 1996

COMMISSION

JUDITH D. ROEHM  
Ontonagon County  
LC 4/35 JEM Fee: 9.00  
Page 1 of 1

LAND CORNER RECORDATION CERTIFICATE  
Filing Requirement of Act 74, Mich. P.A. 1970

For corners in

<u>Ontonagon</u> (County)	Located In:	Corner Code =#
1. Public Land Survey	T <u>47</u> N. R <u>38</u> W.	<u>J-9</u>
	T _____ R _____	_____
	T _____ R _____	_____
	T _____ R _____	_____
2. Property Controlling in Section	S _____ T _____ R _____	_____
	S _____ T _____ R _____	_____
3. Miscellaneous Property in Sec.	S _____ T _____ R _____	_____
	S _____ T _____ R _____	_____
4. Lot No. _____, Recorded Plat _____		
5. Private Claims _____		

Register of Deeds Stamp & File Number

Quarter Corner 23 & 26; T.47 N., R.38 W.

I, Richard L. Drahn in a field survey on August 17, 19 95, do hereby certify that under requirements of P.A. 74, Michigan P.A. of 1970, the corner points mentioned in lines 1 and 2 above were in conformance with regulations and rules therefore as required in the current manual of survey instructions of the United States Department of the Interior, Bureau of Land Management or by a decree of a Court of Law and/or that the corner points mentioned in lines 3, 4 and 5 above were in conformance with the rules of the Michigan Board of Land Surveyors or by a Decree of a Court of Law; established, re-established, monumented, re-monumented, recovered, found as expressed below:

A	B	C	D	E	F	G	H	I	J	K	L	M
2	6	5	4	3	2	1						
3												
4	7	8	9	10	11	12						
5												
6	18	17	16	15	14	13						
7												
8	19	20	21	22	23	24						
9												
10	30	29	28	27	26	25						
11												
12	31	32	33	34	35	36						
13												

NOTE: Not more than 4 corners, all in the same town and range, may be recorded on this certificate.

A. Description of original monument and accessories and/or subsequent restoration:  
Original corner established by Z. B. Searls, Deputy Surveyor on June 18, 1851.

Original bearing trees:

Hemlock	20"	S.40 E.	49 links	(32.34 feet)
Hemlock	20"	N.16 W.	29 links	(19.14 feet)

Record research on file with Ontonagon County Representative.


B. Description of corner evidence found and/or method applied in restoring or reestablishing corner:  
No evidence of original corner or bearing trees found. Corner position re-established on line between and equal distance from the southeast and south west section corners of section 23; T.47 N., R.38 W.

PEER GROUP APPROVED

*Earl Applbaum*  
COUNTY REPRESENTATIVE 1-17-96

C. Description of monument for corner and accessories established to perpetuate locating the position of the corner:  
At the corner position I set a 2½" dia. by 30" long aluminum monument with a 3¼" aluminum cap, stamped to read: T.47 N., R.38 W.; ¼; S-23, S-26; 1995; R.L.S. 21564. From which I established the following new blazed and scribed bearing trees:

6"	Aspen	N.37 E.	5.39 feet
7"	Aspen	S.50 W.	17.27 feet
9"	W. Birch	N.01 E.	21.77 feet
6'	Steel rail	South	1.53 feet

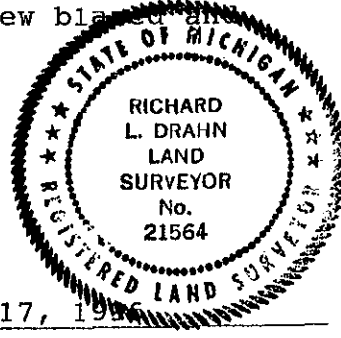

Signed by Richard L. Drahn Date January 17, 1996

Surveyor's Michigan License No. 21564