


LAND CORNER RECORDATION CERTIFICATE
Filing Requirement of Act 74, Mich. P.A. 1970
Ontonagon County Remonumentation Corner

Ontonagon County

Page 1 of 1
Date Rec. Date 08/03/98 Time 09:20
RECORDING FEE: 9.00

For corners in

Table with columns: Ontonagon County, Located in:, Corner Code #. Includes entries for Public Land Survey, Property Controlling in Section, Miscellaneous Property in Sec., Lot No., and Private Claims.

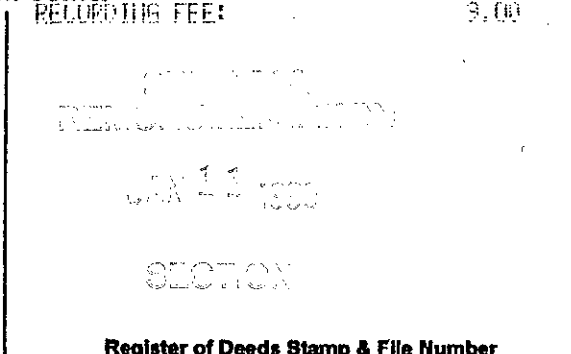

I, Joseph C. Domitrovich, in a field survey on July 21, 1998, do hereby state that under requirements of P.A. 74, Michigan P.A. of 1970, the corner points mentioned in lines 1 and 2 above were in conformance with regulations and rules...

NOTE: Not more than 2 corners, all in the same town and range, may be recorded on this certificate.

Grid table with columns A-M and rows 1-13, used for recording corner locations.

A. Description of original monument and accessories and/or subsequent restoration:

(K-4) 1/4 Corner Common to Sections 11 & 12, T47N, R38W

1851 - Zelotes B. Searis set a post.
8" Cedar S 81° W 12 links
6" Spruce N 39° E 16 links

1889 - Plat of Josephine shows a distance of 1008.30 feet from the North line of the railroad right-of-way to this corner. (1059.86 feet calculated to centerline.)

1891 - Plat of Trout Creek shows a distance of 2643.00 feet from the Southwest Corner of Section 12 to this corner.

1946 - Supervisor's Plat No. 1 of the Southwest 1/4 of Section 12, T47N, R38W, shows a distance of 1529.85 feet from the Southwest Corner of Section 12 to the South line of the railroad right-of-way. (1581.41 feet calculated to the centerline.)

B. Description of corner evidence found and/or method applied in restoring or reestablishing corner:

I found no remains of the original Corner or accessories. North-South Division Street now runs over the area of the 1/4 Corner. I calculated a position for the Corner using Plat Monumentation in the Plat of Trout Creek...

Research on file with County Remonumentation Representative.

C. Description of monument for corner and accessories established to perpetuate locating the position of the corner:

Corner is a 5/8" iron pin with a 3" diameter aluminum cap stamped: COUNTY REMONUMENTATION; 1/4, S.11, S.12; T.47N, R.38W; 1998; P.S. 37273. I also established a reference monument (R.M.) to the Southeast, a 1/2" x 36" aluminum rod with 3" diameter aluminum cap stamped to indicate that the 1/4 Corner is N 86° W a distance of 24.42 feet.

Witnesses table with columns: Witness, Bearing, Distance. Includes Transformer Pole, Railroad Spike, Iron Pin, Light Pole, Apple Tree Clump, R.M., SW Cor. Sec. 12, NW Cor. Sec. 12, 1" Iron Pin.

(NW Cor. Plat of Trout Creek, 1377...)

NOTE: Bearings to witness objects are magnetic. Distances are to a nail in side of the witness object unless noted.

Signed by [Signature]

Date 7/22/98

Surveyor's Michigan License No. 37273

