

SURVEY & REMONUMENTATION

APR 29 1996

COMMISSION

JUDITH D. ROEHM
Ontonagon County
LC 3/310 JEM Fee: 9.00
09/22/95
08:42
Page 1 of 1

LAND CORNER RECORDATION CERTIFICATE Filing Requirement of Act 74, Mich. P.A. 1970

For corners in ONTONAGON Located In: _____ Corner Code # _____
(County)

- | | | | |
|--------------------------------------|-------------|-------------|---------------|
| 1. Public Land Survey | T <u>48</u> | R <u>40</u> | E-13
E-1 ✓ |
| | T <u>47</u> | R <u>40</u> | |
| | T _____ | R _____ | |
| | T _____ | R _____ | |
| 2. Property Controlling in Section | S _____ | T _____ | R _____ |
| | S _____ | T _____ | R _____ |
| 3. Miscellaneous Property in Section | S _____ | T _____ | R _____ |
| | S _____ | T _____ | R _____ |

Register of Deeds Stamp & File Number

4. Lot No. _____, Recorded Plat _____
5. Private Claims _____

Section Corner common to S32 & 33, T48N R40W, S4 & S5, T47N R40W.

I, Earl W. Applekamp, in a field survey on August 03, 19 95, do hereby certify that under requirements of P.A. 74, Michigan P.A. of 1970, the corner points mentioned in lines 1 and 2 above were in conformance with regulations and rules therefore as required in the current manual of survey instructions of the United States Department of the Interior, Bureau of Land Management or by a decree of a Court of Law and/or that the corner points mentioned in lines 3, 4 and 5 above were in conformance with the rules of the Michigan Board of Professional Surveyors or by a Decree of a Court of Law; established, re-established, monumented, re-monumented, recovered, found as expressed below:

A	B	C	D	E	F	G	H	I	J	K	L	M
2	6	5	4	3	2	1						
3												
4	7	8	9	10	11	12						
5												
6	18	17	16	15	14	13						
7												
8	19	20	21	22	23	24						
9												
10	30	29	28	27	26	25						
11												
12	31	32	33	34	35	36						
13												

NOTE: Not more than 4 corners, all in the same town and range, may be recorded on this certificate.

A. Description of original monument and accessories and/or subsequent restoration:

Original corner established by Wills Burt, U.S. Deputy Surveyor, June 1857. Set Cedar Post.

ORIGINAL BEARING TREES:

White Pine	40"	N59°E	55 links	(36.30 feet)
Cedar	18"	N49°W	41 links	(27.06 feet)

B. Description of corner evidence found and/or method applied in restoring or reestablishing corner:

No original evidence was found. There is a County gravel road running N-S and another running West from the apparent corner. A distance of 5266.84 feet was measured from the centerline of the "T" roadway. This location is the most logical point for the corner. I accepted the centerline of the two roads and set a monument described in "C" below.


PEER GROUP APPROVED

Earl W. Applekamp 9-20-95
COUNTY REPRESENTATIVE

C. Description of monument for corner and accessories established to perpetuate locating the position of the corner:

At the corner position I set a 3/4"x24" aluminum rod with a 3/4" aluminum cap 4" below the gravel surface. The cap is stamped to read: COUNTY REMONUMENTATION, T48N R40W, T47N R40W, S32, S33, S4, S5, 1995, P.S. 17610 I established the following bearing trees and reference objects.

6" Aspen	N23°W	165.31 feet	-	REA Power Pole	N42°E	44.00 feet
7" Aspen	S19°E	112.15 feet	-	Steel Sign Post	East	27.82 feet

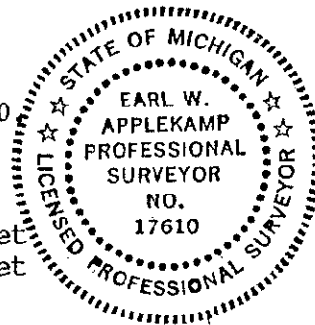

Signed by Earl W. Applekamp
Surveyor's Michigan License No. 17610

Date September 20, 1995