

SURVEY & REMONUMENTATION

DEC 16 1996

COMMISSION

JUDITH D. ROEHM
Ontonagon County
LC 4/101 JEM

07/11/96
08:49

Fee: 9.00
Page 1 of 1

LAND CORNER RECORDATION CERTIFICATE
Filing Requirement of Act 74, Mich. P.A. 1970

For corners in

ONTONAGON
(County)

Located in:

Corner Code #

1. Public Land Survey

T47N R 40W

K-1
K-13

T48N R 40W

T R

T R

2. Property Controlling in Section

S T R

S T R

3. Miscellaneous Property in Sec.

S T R


S T R

4. Lot No. _____, Recorded Plat _____
5. Private Claims _____

Section Corner common to Sections 1 & 2, T47N R40W and Sections 35 & 36, T48N R40W.

I, Earl W. Applekamp, in a field survey on June 20, 1996 do hereby state that under requirements of P.A. 74, Michigan P.A. of 1970, the corner points mentioned in lines 1 and 2 above were in conformance with regulations and rules therefore as required in the current manual of survey instructions of the United States Department of the Interior, Bureau of Land Management or by a decree of a Court of Law and for that the corner points mentioned in lines 3, 4 and 5 above were in conformance with the rules of the Michigan Board of Land Surveyors or by a Decree of a Court of Law; established, re-established, monumented, recovered, found as expressed below:

NOTE: Not more than 2 corners, all in the same town and range, may be recorded on this certificate.

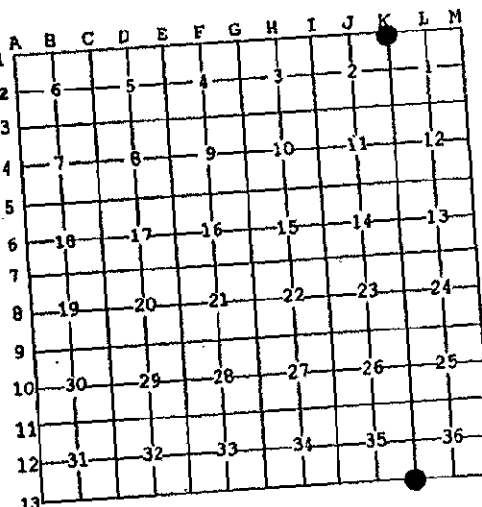

A. Description of original monument and accessories and/or subsequent restoration:

Original corner established by John Burt, U.S. Deputy Surveyor, July 12, 1847. Set Sugar Post.

ORIGINAL BEARING TREES:

Cedar	16"	N57°E	38 links
Henlock	16"	N62°W	32 links

PEER GROUP APPROVED

Earl W. Applekamp
COUNTY REPRESENTATIVE

07-08-96

B. Description of corner evidence found and/or method applied in restoring or reestablishing corner:


No original evidence was found. At the corner position I found a 1" drill steel one inch below top of blacktop. This corner had been set and used by E.W. Applekamp, No. 17610 in 1982. The drill steel location is in conformance with occupied land and original original field note measurements and calls. I accepted the drill steel as being the true position.

On file with the Ontonagon County Remonumentation Program Representative.

C. Description of monument for corner and accessories established to perpetuate locating the position of the corner:

At the corner position I left the 1" drill steel in place. I established two reference monuments which are 2 1/2"x30" aluminum pipe with a 3 1/4" cap stamped to read: County Remonumentation, R.M. T47N, T48N, R40W, S1, S2, S35, S36, 1996, P.S. 17610. I also established two other reference objects.

REF. MON.	S63°-30'-18"W	43.18'	- REA P.Pole	S07°-45'-24"W	225.81'
REF. MON.	N49°-04'-16"E	47.66'	- REA P.Pole	N10°-09'-10"W	177.95'

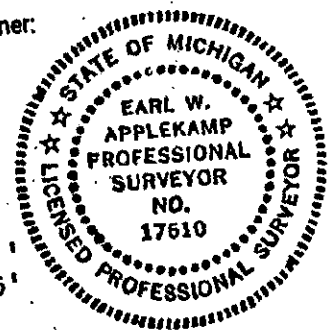

Signed by Earl W. Applekamp
Surveyor's Michigan License No. 17610

Date June 27, 1996