

OCT 3 0 1997

COMMISSION

LAND CORNER RECORDATION CERTIFICATE
Filing Requirement of Act 74, Mich. P.A. 1970

For corners in

ONTONAGON
(County)

Located In: Corner Code #

1. Public Land Survey

T48N R39W
T48N R38W
T R
T R
T R

M-4
A-4 ✓

2. Property Controlling in Section

S T R
S T R
S T R

3. Miscellaneous Property in Sec.

S T R
S T R

JUDITH D. ROEHM 06/12/97
Ontonagon County 09:44
C 4/271 JJT Fee: 9.00
Page 1 of 1

Register of Deeds Stamp & File Number

4. Lot No. _____ Recorded Plat _____
5. Private Claims _____

Quarter Corner common to Sections 12 & 7, T48N R38 & R39W.

I, Earl W. Applekamp, in a field survey on May 29, 1997 do hereby state that under requirements of P.A. 74, Michigan P.A. of 1970, the corner points mentioned in lines 1 and 2 above were in conformance with regulations and rules therefore as required in the current manual of survey instructions of the United States Department of the Interior, Bureau of Land Management or by a decree of a Court of Law and for that the corner points mentioned in lines 3, 4 and 5 above were in conformance with the rules of the Michigan Board of Land Surveyors or by a Decree of a Court of Law; established, re-established, monumented, recovered, found as expressed below:

NOTE: Not more than 2 corners, all in the same town and range, may be recorded on this certificate.

	A	B	C	D	E	F	G	H	I	J	K	L	M
1													
2		6		5		4		3		2		1	
3													
4	7		8		9		10		11		12		
5													
6		18		17		16		15		14		13	
7													
8		19		20		21		22		23		24	
9													
10		30		29		28		27		26		25	
11													
12		31		32		33		34		35		36	
13													

A. Description of original monument and accessories and/or subsequent restoration:

Original corner established by Austin Burt, U.S. Deputy Surveyor, July 12, 1847. Set Maple Post.

ORIGINAL BEARING TREES:

10" Cedar S72°E 3.96 feet
10" Cedar N42½°W 19.80 feet

B. Description of corner evidence found and/or method applied in restoring or reestablishing corner:

No original evidence was found. Corner position falls at the intersection of four county gravel roads. This position is in conformance with the original G.L.O. notes. Corner was re-established at the intersection of the four gravel roads as being the only logical position for the corner.

Research on file with the Ontonagon County Remonumentation Program Representative.


PEER GROUP APPROVED

Earl W. Applekamp
COUNTY REPRESENTATIVE 6-10-97

C. Description of monument for corner and accessories established to perpetuate locating the position of the corner:

At the corner position I set a 5/8"x12" rebar with a 3" stamped cap 6" below top of gravel road. I established a reference monument, a 2½"x30" aluminum pipe with a 3" cap stamped to read: County Remonumentation, T48N, R38W, R39W, R.M., ¼, S12, S7, 1997, P.S. 17610. I established three other witness objects.

REF. MON. S54°W 45.03 feet - Power Pole N39°E 31.39 feet
Power Pole N57°W 35.68 feet - 8" Apple Tree S22°W 54.45 feet

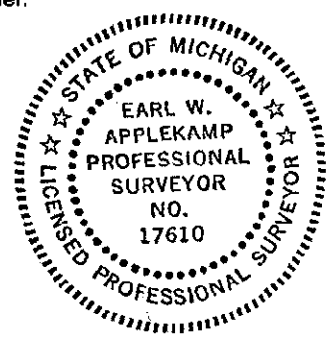

Signed by Earl W. Applekamp
Surveyor's Michigan License No. 17610

Date June 7, 1997