

LAND CORNER RECORDATION CERTIFICATE
Filing Requirement of Act 74, Mich. P.A. 1970

For corners in

<u>ONTONAGON</u> (County)	Located In:	Corner Code #
1. Public Land Survey	T <u>48N</u> R <u>39W</u>	<u>B-7</u>
	T <u> </u> R <u> </u>	<u> </u>
	T <u> </u> R <u> </u>	<u> </u>
	T <u> </u> R <u> </u>	<u> </u>
2. Property Controlling in Section	S <u> </u> T <u> </u> R <u> </u>	<u> </u>
	S <u> </u> T <u> </u> R <u> </u>	<u> </u>
3. Miscellaneous Property in Sec.	S <u> </u> T <u> </u> R <u> </u>	<u> </u>
	S <u> </u> T <u> </u> R <u> </u>	<u> </u>

**SURVEY &
 REMONUMENTATION**

MAY 22 1997

COMMISSION

Register of Deeds Stamp & File Number

4. Lot No. _____, Recorded Plat _____
 5. Private Claims _____

$\frac{1}{4}$ Corner common to Sections 18 & 19, T48N R39W.

I, Earl W. Applekamp, in a field survey on July 03, 1996 do hereby state that under requirements of P.A. 74, Michigan P.A. of 1970, the corner points mentioned in lines 1 and 2 above were in conformance with regulations and rules therefore as required in the current manual of survey instructions of the United States Department of the Interior, Bureau of Land Management or by a decree of a Court of Law and /or that the corner points mentioned in lines 3, 4 and 5 above were in conformance with the rules of the Michigan Board of Land Surveyors or by a Decree of a Court of Law; established, re-established, monumented, recovered, found as expressed below:

NOTE: Not more than 2 corners, all in the same town and range, may be recorded on this certificate.

1	A	B	C	D	E	F	G	H	I	J	K	L	M
2		6		5		4		3		2		1	
3													
4		7		8		9		10		11		12	
5													
6		18		17		16		15		14		13	
7													
8		19		20		21		22		23		24	
9													
10		30		29		28		27		26		25	
11													
12		31		32		33		34		35		36	
13													

A. Description of original monument and accessories and/or subsequent restoration:

Original corner established by Artemas Curtis, U.S. Deputy Surveyor, September 05, 1851. Set Hemlock Post.

ORIGINAL BEARING TREES:

Aspen 16" N40°E 15.18 feet
 Spruce 9" S45°W 3.30 feet

B. Description of corner evidence found and/or method applied in restoring or reestablishing corner:

No original evidence was found. The calculated position of the corner fall six feet East of the centerline of North Baltimore Road and about one foot South of an existing fence running East and West. Corner was re-established at the intersection of the centerline of the North Baltimore Road and the fence lines running East and West.


Research on file with the Ontonagon County Remonumentation Program Representative.

PEER GROUP APPROVED
Earl W. Applekamp
 COUNTY REPRESENTATIVE
 9-12-96

C. Description of monument for corner and accessories established to perpetuate locating the position of the corner:

At the corner position I set a 5/8"x24" rebar with a 3/4" stamped cap 2" below top of blacktop in the centerline of the North Baltimore Road. I established one reference monument, a 2 1/2"x30" aluminum pipe with a 3/4" cap stamped to read: County Remonumentation, T48N R39W, R.M., 1/4, S18, S19, 1996, P.S. 17610. I also established 3 other bearing trees and reference objects.

REF. MON. S66°-44'-19"W 32.79' - P. Pole N77°-13'-21"E 31.96'
 7" W. Pine S39°-26'-34"W 114.25' - P. Pole S05°-09'-23"E 319.49'

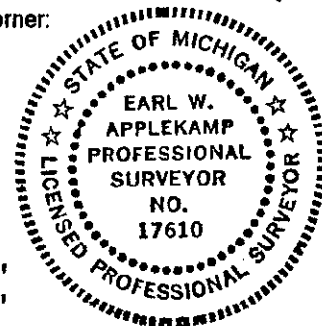

Signed by *Earl W. Applekamp*
 Surveyor's Michigan License No. 17610

Date August 21, 1996