

LAND CORNER RECORDATION CERTIFICATE
 Filing Requirement of Act 74, Mich. P.A. 1970

For corners in
ONTONAGON
 (County)

Located In:	Corner Code #
T 48NR 39W	C-8
T R	
T R	
T R	
S T R	
S T R	
S T R	
S T R	

SURVEY &
 REMONUMENTATION
 MAY 22 1997
 COMMISSION
 Register of Deeds Stamp & File Number


- 1. Public Land Survey
- 2. Property Controlling in Section
- 3. Miscellaneous Property in Sec.

4. Lot No. _____, Recorded Plat _____
 5. Private Claims _____

1/4 Corner common to Sections 19 & 20, T48N R39W.

I, Earl W. Applekamp, in a field survey on July 03, 1996 do hereby state that under requirements of P.A. 74, Michigan P.A. of 1970, the corner points mentioned in lines 1 and 2 above were in conformance with regulations and rules therefore as required in the current manual of survey instructions of the United States Department of the Interior, Bureau of Land Management or by a decree of a Court of Law and/or that the corner points mentioned in lines 3, 4 and 5 above were in conformance with the rules of the Michigan Board of Land Surveyors or by a Decree of a Court of Law; established, re-established, monumented, recovered, found as expressed below:

NOTE: Not more than 2 corners, all in the same town and range, may be recorded on this certificate.

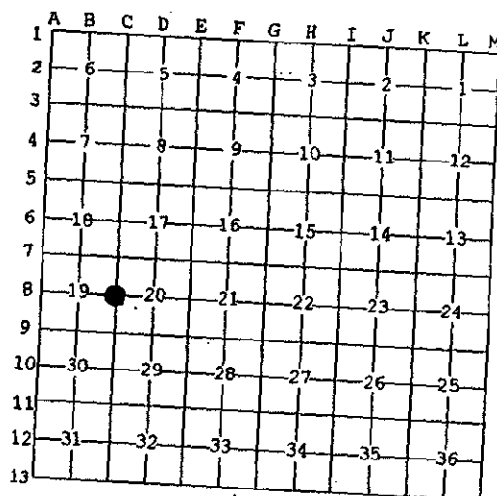

A. Description of original monument and accessories and/or subsequent restoration:

Original corner established by Artemas Curtis, U.S. Deputy Surveyor, September 05, 1851. Set Wood Post.

ORIGINAL BEARING TREES:

Yellow Birch	8"	N25°W	6.60 feet
Cedar	11"	S35°E	19.14 feet

B. Description of corner evidence found and/or method applied in restoring or reestablishing corner:

No original evidence was found. The apparent corner position is in a gravel road running North & South. The corner was re-established by single proportionate measurement between opposite section corners North & South and in the centerline of the gravel road.

Research on file with the Ontonagon County Remonumentation Program Representative.

PEER GROUP APPROVED
Earl W. Applekamp
 COUNTY REPRESENTATIVE 8-14-96

C. Description of monument for corner and accessories established to perpetuate locating the position of the corner:

At the corner position I set a 5/8"X24" rebar with a 3 1/4" stamped cap 6" below the top of the gravel road. I established one reference monument, a 2 1/2"X30" aluminum pipe with a 3 1/4" cap stamped to read: County Remonumentation, T48N R39W, 1/4, R.M., S19, S20, 1996, P.S. 17610. I established three bearing trees.

REF. MON.	N88°-40'-04"W	24.79'	-	4" Aspen	N37°W	46.20'
10" Maple	S23°W	121.41'	-	4" W. Birch	N50°E	82.38'



Signed by Earl W. Applekamp
 Surveyor's Michigan License No. 17610

Date August 14, 1996