

**SURVEY &
REMONUMENTATION**

MAY 05 1997

COMMISSION

JUDITH D. ROEHM
Ontonagon County
LC 4/ 59 JEM

05/09/96
14:28
Fee: 9.00
Page 1 of 1

LAND CORNER RECORDATION CERTIFICATE
Filing Requirement of Act 74, Mich. P.A. 1970

For corners in

<u>ONTONAGON</u> (County)	Located In:	Corner Code #
1. Public Land Survey	T <u>48N</u> R <u>39W</u>	<u>C-9</u>
	T ___ R ___	_____
	T ___ R ___	_____
	T ___ R ___	_____
2. Property Controlling in Section	S ___ T ___ R ___	_____
	S ___ T ___ R ___	_____
3. Miscellaneous Property in Sec.	S ___ T ___ R ___	_____
	S ___ T ___ R ___	_____


Register of Deeds Stamp & File Number

4. Lot No. _____, Recorded Plat _____
5. Private Claims _____

Section Corner common to 19, 20, 29 & 30, T48N R39W.

I, Earl W. Applekamp, in a field survey on April 18, 1996 do hereby state that under requirements of P.A. 74, Michigan P.A. of 1970, the corner points mentioned in lines 1 and 2 above were in conformance with regulations and rules therefore as required in the current manual of survey instructions of the United States Department of the Interior, Bureau of Land Management or by a decree of a Court of Law and/or that the corner points mentioned in lines 3, 4 and 5 above were in conformance with the rules of the Michigan Board of Land Surveyors or by a Decree of a Court of Law, established, re-established, monumented, recovered, found as expressed below:

NOTE: Not more than 2 corners, all in the same town and range, may be recorded on this certificate.

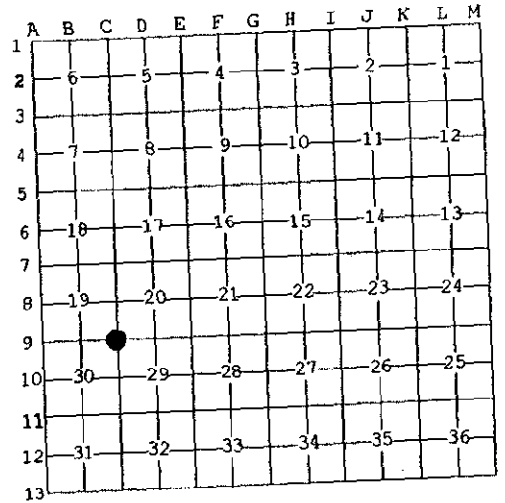

A. Description of original monument and accessories and/or subsequent restoration:

Corner established by Artemas Curtis, U.S. Deputy Surveyor, April 1851. Set Cedar Post.

ORIGINAL BEARING TREES:

W. Birch 7" N55°E 31 links
W. Pine 16" S55°W 3 links

PEER GROUP APPROVED

Earl W. Applekamp 5-07-96
COUNTY REPRESENTATIVE

B. Description of corner evidence found and/or method applied in restoring or reestablishing corner:

At the corner position I found a 3/4" bolt in a box in the blacktop on Michigan Highway M-28. This corner has been in since 1963. The location is in conformance with the Railroad R.O.W. constructed in 195, North of the corner. Distances to original call distances are in conformance. I accepted the location and monumented the corner.

Research on file with Ontonagon County Remonumentation Representative.

C. Description of monument for corner and accessories established to perpetuate locating the position of the corner:

At the corner position is a 3/4" bolt with a 1" head in a monument box. I set two reference monuments, a 2 1/2"x30" aluminum pipe with a 3 1/2" cap stamped to read: County Remonumentation, RM, S19, S20, S29, S30, T48N R39W, 1996, P.S. 17610. I established two other reference objects.
REF. MON. N34°-38'-45"W 89.31' P. Pole S70°12'-43"E 150.95'
REF. MON. N33°-14'-55"E 91.81' P. Pole S49°-34'-05"W 80.04'



Signed by Earl W. Applekamp
Surveyor's Michigan License No. 17610

Date April 29, 1996