

**LAND CORNER RECORDATION CERTIFICATE**  
 Filing Requirement of Act 74, Mich. P.A. 1970

For corners in

ONTONAGON (County)	Located In:	Corner Code #
1. Public Land Survey	T48N R39W	C-11
	T___ R___	_____
	T___ R___	_____
	T___ R___	_____
2. Property Controlling in Section	S___ T___ R___	_____
	S___ T___ R___	_____
3. Miscellaneous Property in Sec.	S___ T___ R___	_____
	S___ T___ R___	_____

**SURVEY &  
 REMONUMENTATION**  
 MAY 22 1997  
**COMMISSION**

Register of Deeds Stamp & File Number

4. Lot No. \_\_\_\_\_, Recorded Plat \_\_\_\_\_  
 5. Private Claims \_\_\_\_\_

Section Corner common to 29, 30, 31 & 32, T48N R39W.

Earl W. Applekamp, in a field survey on July 29, 1996 do hereby state that under requirements of P.A. 74, Michigan P.A. of 1970, the corner points mentioned in lines 1 and 2 above were in conformance with regulations and rules therefore as required in the current manual of survey instructions of the United States Department of the Interior, Bureau of Land Management or by a decree of a Court of Law and/or that the corner points mentioned in lines 3, 4 and 5 above were in conformance with the rules of the Michigan Board of Land Surveyors or by a Decree of a Court of Law; established, re-established, monumented, recovered, found as expressed below:

NOTE: Not more than 2 corners, all in the same town and range, may be recorded on this certificate.

	A	B	C	D	E	F	G	H	I	J	K	L	M
1													
2	6		5		4		3		2		1		
3													
4	7		8		9		10		11		12		
5													
6	18		17		16		15		14		13		
7													
8	19		20		21		22		23		24		
9													
10	30		29		28		27		26		25		
11													
12	31		32		33		34		35		36		
13													

A. Description of original monument and accessories and/or subsequent restoration:

Original corner established by Artemas Curtis, U.S. Deputy Surveyor, September 13, 1851. Set Hemlock Post.

ORIGINAL BEARING TREES:

W. Pine 18" N60°W 21.78 feet  
 Y. Birch 18" S30°E 27.72 feet

B. Description of corner evidence found and/or method applied in restoring or reestablishing corner:

No original evidence was found. At the apparent corner location there is an old fence (50 years ±) running East & West and a gravel road running North & South. A GLO stream call South agrees with this location. Corner was re-established at the centerline of the gravel road and the intersection of the two fence lines.


Research on file with the Ontonagon County Remonumentation Program Representative.

C. Description of monument for corner and accessories established to perpetuate locating the position of the corner:

At the corner position I set a 5/8"x24" rebar with a 3/4" stamped cap 6" below the surface and in the centerline of the gravel road. I established one reference monument, a 2 1/2"x30" aluminum pipe with a 3/4" cap stamped to read: County Remonumentation, T48N R39W, S29, S30, S31, S32, 1996, P.S. 17610. I established three bearing objects.

REF. MO. S89°-57'-05"E 38.38' - REA P. Pole S05°-28'-26"W 353.75'  
 11" Red Pine N35°-12'-40"E 69.81' - REA P. Pole N89°-38'-05"W 33.26'

PEER GROUP APPROVED  
 Earl W. Applekamp  
 COUNTY REPRESENTATIVE  
 8-14-96

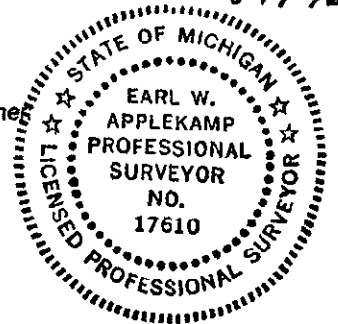

Signed by Earl W. Applekamp  
 Surveyor's Michigan License No. 17610

Date August 12, 1996