

LAND CORNER RECORDATION CERTIFICATE
 Filing Requirement of Act 74, Mich. P.A. 1970

For corners in

Located In:	Corner Code #
<u>ONTONAGON</u> (County)	
1. Public Land Survey	T48NR 39W <u>D-7</u>
	T ___ R ___
	T ___ R ___
	T ___ R ___
2. Property Controlling in Section	S ___ T ___ R ___
	S ___ T ___ R ___
3. Miscellaneous Property in Sec.	S ___ T ___ R ___
	S ___ T ___ R ___

SURVEY & REMONUMENTATION

MAY 22 1997


Register of Deeds Stamp & File Number

4. Lot No. _____, Recorded Plat _____
 5. Private Claims _____

$\frac{1}{4}$ Corner common to Sections 17 & 20, T48N R39W.

I, Earl W. Applekamp, in a field survey on August 01 19 96 do hereby state that under requirements of P.A. 74, Michigan P.A. of 1970, the corner points mentioned in lines 1 and 2 above were in conformance with regulations and rules therefore as required in the current manual of survey instructions of the United States Department of the Interior, Bureau of Land Management or by a decree of a Court of Law and/or that the corner points mentioned in lines 3, 4 and 5 above were in conformance with the rules of the Michigan Board of Land Surveyors or by a Decree of a Court of Law, established, re-established, monumented, recovered, found as expressed below.

NOTE: Not more than 2 corners, all in the same town and range, may be recorded on this certificate.

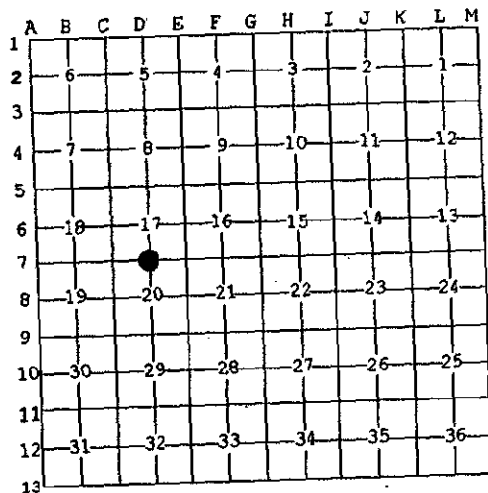

A. Description of original monument and accessories and/or subsequent restoration:

Original corner established by Artemas Curtis, U.S. Deputy Surveyor, September 07, 1851. Set Wood Post.

ORIGINAL BEARING TREES:

Aspen 12" N32°W 3.30 feet
 Aspen 9" S25°E 15.18 feet

B. Description of corner evidence found and/or method applied in restoring or reestablishing corner:

No original evidence was found. At the calculated corner position I found an old fence (60-70 years) running East and South. Corner was re-established by single proportionate measurement and on line between opposite section corners.


PEER GROUP APPROVED
Earl W. Applekamp
 COUNTY REPRESENTATIVE 08-08-96

Research on file with the Ontonagon County Remonumentation Program Representative.

C. Description of monument for corner and accessories established to perpetuate locating the position of the corner:

At the corner position I set a 2 $\frac{1}{2}$ "x30" aluminum pipe with a 3 $\frac{1}{4}$ " cap stamped to read: County Remonumentation, T48N R39W, $\frac{1}{4}$, S17, S20, 1996, P.S. 17610. I established four bearing trees and objects.

6" Ash N63°-05'-34"W 23.97' - 7" Maple N62°-01'-51"E 28.91'
 9" Maple S00°-43'-11"W 28.04' - Steel sign post North 1.10'

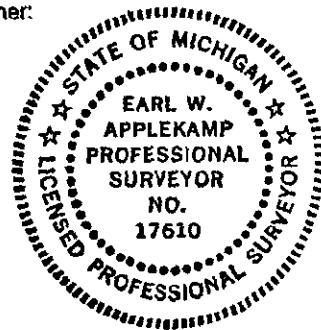

Signed by Earl W. Applekamp
 Surveyor's Michigan License No. 17610

Date August 7, 1996