

LAND CORNER RECORDATION CERTIFICATE
 Filing Requirement of Act 74, Mich. P.A. 1970

For corners in

| ONTONAGON (County) | Located In: | Corner Code # |
|---------------------------------------|---------------------------|---------------|
| 1. Public Land Survey | T <u>48N</u> R <u>39W</u> | <u>D-11</u> |
| | T ___ R ___ | _____ |
| | T ___ R ___ | _____ |
| | T ___ R ___ | _____ |
| 2. Property Controlling in Section | S ___ T ___ R ___ | _____ |
| | S ___ T ___ R ___ | _____ |
| 3. Miscellaneous Property in Sec. | S ___ T ___ R ___ | _____ |
| | S ___ T ___ R ___ | _____ |

SURVEY &
 REMONUMENTATION

MAY 22 1997


COMMISSION

Register of Deeds Stamp & File Number

4. Lot No. _____, Recorded Plat _____
 5. Private Claims _____

$\frac{1}{4}$ Corner common to Sections 29 & 32, T48N R39W.

I, Earl W. Applekamp, in a field survey on August 8, 1996 do hereby state that under requirements of P.A. 74, Michigan P.A. of 1970, the corner points mentioned in lines 1 and 2 above were in conformance with regulations and rules therefore as required in the current manual of survey instructions of the United States Department of the Interior, Bureau of Land Management or by a decree of a Court of Law and/or that the corner points mentioned in lines 3, 4 and 5 above were in conformance with the rules of the Michigan Board of Land Surveyors or by a Decree of a Court of Law; established, re-established, monumented, recovered, found as expressed below:

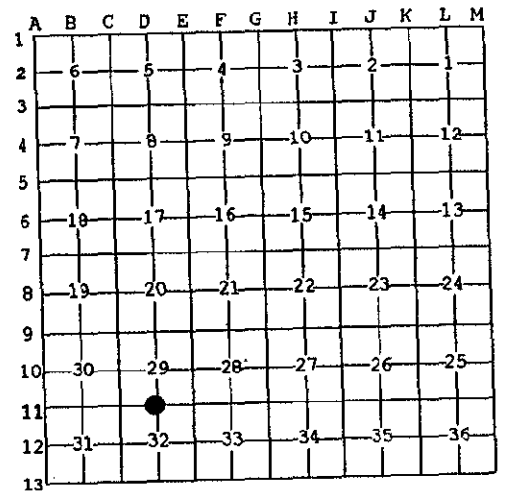

NOTE: Not more than 2 corners, all in the same town and range, may be recorded on this certificate.

A. Description of original monument and accessories and/or subsequent restoration:

Original corner established by Artemas Curtis, U.S. Deputy Surveyor, September 15, 1851. Set Wood Post.

ORIGINAL BEARING TREES:

Sugar 8" N40°E 13.20 feet
 Sugar 8" S60°W 15.18 feet

B. Description of corner evidence found and/or method applied in restoring or reestablishing corner:

No original evidence was found. There was no record found for restoring the corner. No evidence was found at the site. There is a R.E.A. power line running East and West from the site. A search for fence lines was conducted but none were found. Corner was re-established by single proportionate measurement and on line between opposite section corners.

Research on file with the Ontonagon County Remonumentation Program Representative.

PEER GROUP APPROVED
Earl W. Applekamp
 COUNTY REPRESENTATIVE 8-14-96

C. Description of monument for corner and accessories established to perpetuate locating the position of the corner:

At the corner position I set a 2 $\frac{1}{2}$ "x30" aluminum pipe with a 3 $\frac{1}{4}$ " cap stamped to read: County Remonumentation, T48N R39W, $\frac{1}{4}$, S29, S32, 1996, P.S. 17610. I established four bearing objects.

6" W. Pine N64°-25'-10"W 50.88' - 6" Aspen S16°-27'-56"E 26.20'
 7" W. Pine S73°-01'-06"W 78.37' - Steel Sign Post East 0.91'



Signed by Earl W. Applekamp
 Surveyor's Michigan License No. 17610

Date August 12, 1996