

LAND CORNER RECORDATION CERTIFICATE  
 Filing Requirement of Act 74, Mich. P.A. 1970

For corners in

<u>ONTONAGON</u> (County)	Located In:	Corner Code #
1. Public Land Survey	T <u>48NR</u> <u>39W</u>	<u>E-8</u>
	T ___ R ___	___
	T ___ R ___	___
	T ___ R ___	___
2. Property Controlling In Section	S ___ T ___ R ___	___
	S ___ T ___ R ___	___
3. Miscellaneous Property in Sec.	S ___ T ___ R ___	___
	S ___ T ___ R ___	___

**SURVEY &  
REMONUMENTATION**

MAY 22 1997

**COMMISSION**

Register of Deeds Stamp & File Number

4. Lot No. \_\_\_\_\_, Recorded Plat \_\_\_\_\_  
 5. Private Claims \_\_\_\_\_

1/4 Corner common to Sections 20 & 21, T48N R39W.

I, Earl W. Applekamp, in a field survey on August 01 19 96 do hereby state that under requirements of P.A. 74, Michigan P.A. of 1970, the corner points mentioned in lines 1 and 2 above were in conformance with regulations and rules therefore as required in the current manual of survey instructions of the United States Department of the Interior, Bureau of Land Management or by a decree of a Court of Law and /or that the corner points mentioned in lines 3, 4 and 5 above were in conformance with the rules of the Michigan Board of Land Surveyors or by a Decree of a Court of Law; established, re-established, monumented, recovered, found as expressed below:

NOTE: Not more than 2 corners, all in the same town and range, may be recorded on this certificate.

	A	B	C	D	E	F	G	H	I	J	K	L	M
1													
2	6		5		4		3		2		1		
3													
4	7		8		9		10		11		12		
5													
6	18		17		16		15		14		13		
7													
8	19		20		21		22		23		24		
9													
10	30		29		28		27		26		25		
11													
12	31		32		33		34		35		36		
13													

A. Description of original monument and accessories and/or subsequent restoration:

Original corner established by Artemas Curtis, U.S. Deputy Surveyor September 17, 1851. Set Wood Post.

ORIGINAL BEARING TREES:

Spruce 8" N40°W 9.24 feet  
 W. Pine 8" S60°E 5.28 feet

B. Description of corner evidence found and/or method applied in restoring or reestablishing corner:

No original evidence was found. At the corner position there is a road running North & South. Corner was set by single proportionate measurement between opposite section corners for latitude and using the centerline of the road for departure. The corner position is in conformance with GLO stream calls North & South.


Research on file with the Ontonagon County Remonumentation Program Representative.

PEER GROUP APPROVED  
*Earl W. Applekamp*  
 COUNTY REPRESENTATIVE 08-08-96

C. Description of monument for corner and accessories established to perpetuate locating the position of the corner:

At the corner position I set a 5/8"x24" rebar with a 3 1/4" stamped cap 6" below the gravel surface of the road. I established a reference monument, a 2 1/2" aluminum pipe with a 3 1/4" cap stamped to read: County Remonumentation, T48N R39W, 1/4, R.M. S20, S21, 1996, P.S. 17610. I also established 3 bearing trees..

Ref. Mon. S82°-24'-29"W 23.33' - 7" Maple N31°-44'-28"E 41.28'  
 4" Triple Maple N77°-32'-40"W 32.74' - 7" Aspen S67°-21'-32"E 32.65'

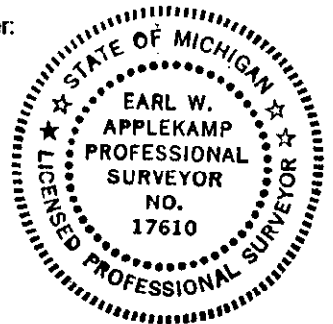

Signed by Earl W. Applekamp  
 Surveyor's Michigan License No. 17610

Date August 6, 1996