

**LAND CORNER RECORDATION CERTIFICATE**  
 Filing Requirement of Act 74, Mich. P.A. 1970

For corners in

<u>ONTONAGON</u> (County)	Located In:	Corner Code #
1. Public Land Survey	T <u>48N</u> R <u>39W</u>	<u>F-11</u>
	T ___ R ___	_____
	T ___ R ___	_____
	T ___ R ___	_____
2. Property Controlling in Section	S ___ T ___ R ___	_____
	S ___ T ___ R ___	_____
3. Miscellaneous Property in Sec.	S ___ T ___ R ___	_____
	S ___ T ___ R ___	_____

**SURVEY &  
 REMONUMENTATION**

MAY 22 1997

COMMISSION

Register of Deeds Stamp & File Number

4. Lot No. \_\_\_\_\_, Recorded Plat \_\_\_\_\_  
 5. Private Claims \_\_\_\_\_

1/4 Corner common to Sections 28 & 33, T48N R39W.

I, Earl W. Applekamp, in a field survey on July 26, 1996 do hereby state that under requirements of P.A. 74, Michigan P.A. of 1970, the corner points mentioned in lines 1 and 2 above were in conformance with regulations and rules therefore as required in the current manual of survey instructions of the United States Department of the Interior, Bureau of Land Management or by a decree of a Court of Law and/or that the corner points mentioned in lines 3, 4 and 5 above were in conformance with the rules of the Michigan Board of Land Surveyors or by a Decree of a Court of Law; established, re-established, monumented, recovered, found as expressed below:

NOTE: Not more than 2 corners, all in the same town and range, may be recorded on this certificate.

A	B	C	D	E	F	G	H	I	J	K	L	M
1												
2	6	5	4	3	2	1						
3												
4	7	8	9	10	11	12						
5												
6	18	17	16	15	14	13						
7												
8	19	20	21	22	23	24						
9												
10	30	29	28	27	26	25						
11												
12	31	32	33	34	35	36						
13												

A. Description of original monument and accessories and/or subsequent restoration:

Original corner established by Artemas Curtis, U.S. Deputy Surveyor, September 16, 1851. Set Wood Post.

ORIGINAL BEARING TREES:

Spruce 8" N60°W 9.90 feet  
 Spruce 14" S24°E 13.20 feet

B. Description of corner evidence found and/or method applied in restoring or reestablishing corner:

No original evidence was found. Corner was re-established at the intersection of the centerline of a county gravel road and a fence line running North & South. This position is 3 1/2 feet West and 6 feet South of a position using single proportionate measurement and on line with opposite section corners.

Research on file with the Ontonagon County Remonumentation Program Representative.

PEER GROUP APPROVED


Earl W. Applekamp  
 COUNTY REPRESENTATIVE

9-12-96

C. Description of monument for corner and accessories established to perpetuate locating the position of the corner:

At the corner position I set a 5/8"x24" rebar with a 3 1/4" stamped cap 6" below and in the centerline of a gravel road. I established one reference monument, a 2 1/2"x30" aluminum pipe with a 3 1/4" cap stamped to read: County Remonumentation, T48N R39W, R.M., 1/4, S28, S33, 1996, P.S. 17610. I also established three other trees and objects.

REF. MON. N00°-36'-45"E 39.82' - 4" Aspen S34°-14'-06"E 58.11'  
 10" Aspen N40°-58'-30"W 73.94' - REA P. Pole S60°-18'-05"W 77.29'

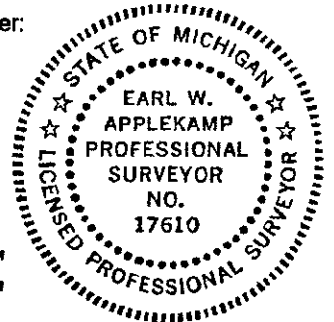

Signed by Earl W. Applekamp  
 Surveyor's Michigan License No. 17610

Date August 16, 1996