

LAND CORNER RECORDATION CERTIFICATE
 Filing Requirement of Act 74, Mich. P.A. 1970

For corners in

ONTONAGON (County)	Located In:	Corner Code #
1. Public Land Survey	T 48NR 39W	G-3
	T ___ R ___	_____
	T ___ R ___	_____
	T ___ R ___	_____
2. Property Controlling in Section	S ___ T ___ R ___	_____
	S ___ T ___ R ___	_____
3. Miscellaneous Property in Sec.	S ___ T ___ R ___	_____
	S ___ T ___ R ___	_____

SURVEY &
REMONUMENTATION
 OCT 30 1997
COMMISSION


Register of Deeds Stamp & File Number

4. Lot No. _____, Recorded Plat _____
 5. Private Claims _____

Section Corner common to Sections 3, 4, 9 & 10, T48N R39W.

I, Earl W. Applekamp, in a field survey on July 18, 1997 do hereby state that under requirements of P.A. 74, Michigan P.A. of 1970, the corner points mentioned in lines 1 and 2 above were in conformance with regulations and rules therefore as required in the current manual of survey instructions of the United States Department of the Interior, Bureau of Land Management or by a decree of a Court of Law and/or that the corner points mentioned in lines 3, 4 and 5 above were in conformance with the rules of the Michigan Board of Land Surveyors or by a Decree of a Court of Law; established, re-established, monumented, recovered, found as expressed below:

NOTE: Not more than 2 corners, all in the same town and range, may be recorded on this certificate.

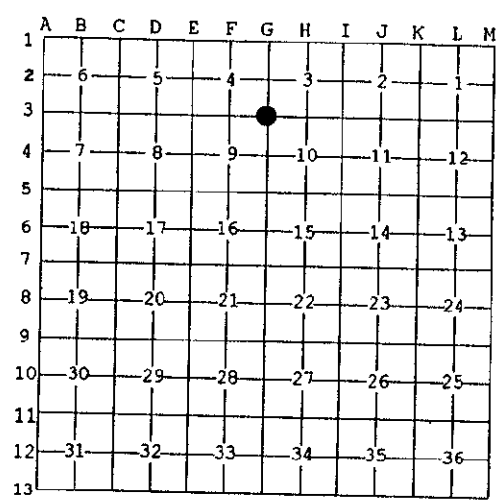

A. Description of original monument and accessories and/or subsequent restoration:

Original corner established by Artemas Curtis, U.S. Deputy Surveyor, September 1851. Set Spruce Post.

ORIGINAL BEARING TREES:

- 8" White Birch N65°W 27.06 feet
- 8" White Birch S80°E 18.48 feet

B. Description of corner evidence found and/or method applied in restoring or reestablishing corner:

At the corner position I found a 1 1/4" I.P. in a monument box 2 feet East of the centerline of Highway US-45 and 28 feet South of a blacktop county road running East. This was shown on the Michigan D.O.T. drawings dated April 20, 1960. Distance on West line of Section 10 and a stream call are in conformance with original notes. I accepted the location as being the only logical position for the corner.

Research on file with the Ontonagon County Remonumentation Program Representative.

PEER GROUP APPROVAL
Earl W. Applekamp
 COUNTY REPRESENTATIVE

8-13-97

C. Description of monument for corner and accessories established to perpetuate locating the position of the corner:

At the corner position I left the 1 1/4" I.P. in the monument box. I established two reference monuments which are 2 1/2" X 30" aluminum pipe with a 3" cap stamped to read: County Remonumentation, T48N R39W, R.M., S3, S4, S9, S10, 1997, P.S. 17610. I also established two other reference objects.

- REF. MON. S64°-25'-52"W 95.38' - P. Pole N21°-18'-31"W 177.22'
- REF. MON. N29°-49'-00"E 138.47' - 5" oak S63°-21'-34"E 84.24'



Signed by Earl W. Applekamp
 Surveyor's Michigan License No. 17610

Date July 26, 1997