

LAND CORNER RECORDATION CERTIFICATE  
 Filing Requirement of Act 74, Mich. P.A. 1970

For corners in

ONTONAGON  
 (County)

Located In:

Corner Code #

1. Public Land Survey	T <u>48N</u> R <u>39W</u>	<u>G-4</u>
	T ___ R ___	_____
	T ___ R ___	_____
	T ___ R ___	_____
2. Property Controlling in Section	S ___ T ___ R ___	_____
	S ___ T ___ R ___	_____
3. Miscellaneous Property in Sec.	S ___ T ___ R ___	_____
	S ___ T ___ R ___	_____

SURVEY &  
 REMONUMENTATION

OCT 30 1997


COMMISSION

Register of Deeds Stamp & File Number

4. Lot No. \_\_\_\_\_, Recorded Plat \_\_\_\_\_  
 5. Private Claims \_\_\_\_\_

$\frac{1}{4}$  Corner common to Sections 9 & 10, T48N R39W.

I, Earl W. Applekamp in a field survey on July 18, 1997 do hereby state that under requirements of P.A. 74, Michigan P.A. of 1970, the corner points mentioned in lines 1 and 2 above were in conformance with regulations and rules therefore as required in the current manual of survey instructions of the United States Department of the Interior, Bureau of Land Management or by a decree of a Court of Law and/or that the corner points mentioned in lines 3, 4 and 5 above were in conformance with the rules of the Michigan Board of Land Surveyors or by a Decree of a Court of Law; established, re-established, monumented, recovered, found as expressed below:

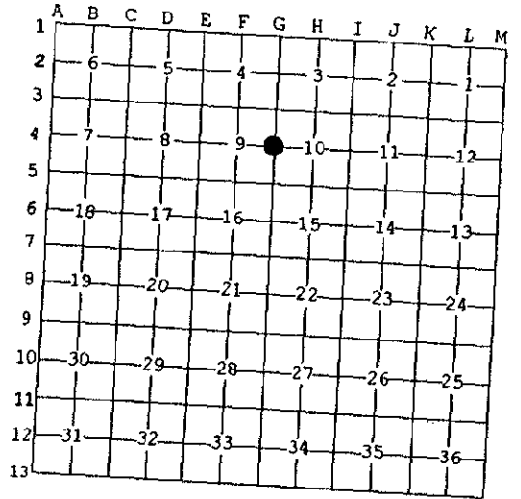

NOTE: Not more than 2 corners, all in the same town and range, may be recorded on this certificate.

A. Description of original monument and accessories and/or subsequent restoration:

Original corner established by Artemas Curtis, U.S. Deputy Surveyor, September 16, 1851. Set W. Pine Post.

ORIGINAL BEARING TREES:

8" Aspen	N25°W	17.16 feet
6" Spruce	S25°E	9.24 feet

B. Description of corner evidence found and/or method applied in restoring or reestablishing corner:

No original evidence was found. Corner position is in U.S. Highway 45. A fence line runs East. A dirt road runs West with fences on both sides. I re-established the  $\frac{1}{4}$  Corner at the intersection of dirt road centerline West and fence line East and on line between opposite Section corners. This conforms to the active occupation of the land in all four directions and is the only logical position for the corner.


Research on file with the Ontonagon County Remonumentation Program Representative.

C. Description of monument for corner and accessories established to perpetuate locating the position of the corner:

At the corner position I set a R.R. spike in the centerline of Highway US-45. I established two reference monuments which are 2 1/2"x30" aluminum pipes with 3" caps stamped to read: County Remonumentation, T48N R39W, R.M.,  $\frac{1}{4}$ , P.S. 17610. I also established two other reference objects.

REF. MON.	N68°-05'-08"E	74.58'	-	P. Pole	S56°-19'-44"W	79.06'
REF. MON.	S40°-35'-02"E	94.05'	-	P. Pole	N18°-42'-01"W	206.16'

PEER GROUP APPROVED  
Earl W. Applekamp  
 COUNTY REPRESENTATIVE  
 8-13-97

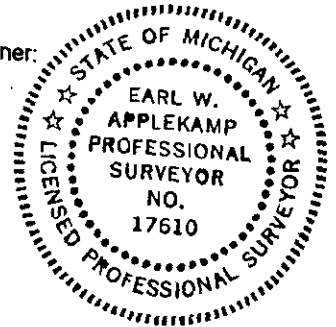

Signed by Earl W. Applekamp  
 Surveyor's Michigan License No. 17610

Date July 29, 1997