


**LAND CORNER RECORDATION CERTIFICATE**  
 Filing Requirement of Act 74, Mich. P.A. 1970

For corners in

ONTONAGON (County)	Located in:	Corner Code #
1. Public Land Survey	T <u>48NR 39W</u>	G-6
	T ___ R ___	_____
	T ___ R ___	_____
	T ___ R ___	_____
2. Property Controlling in Section	S ___ T ___ R ___	_____
	S ___ T ___ R ___	_____
3. Miscellaneous Property in Sec.	S ___ T ___ R ___	_____
	S ___ T ___ R ___	_____

**SURVEY &  
 REMONUMENTATION**  
 MAY 22 1997  
**COMMISSION**  
 Register of Deeds Stamp & File Number

4. Lot No. \_\_\_\_\_, Recorded Plat \_\_\_\_\_  
 5. Private Claims \_\_\_\_\_

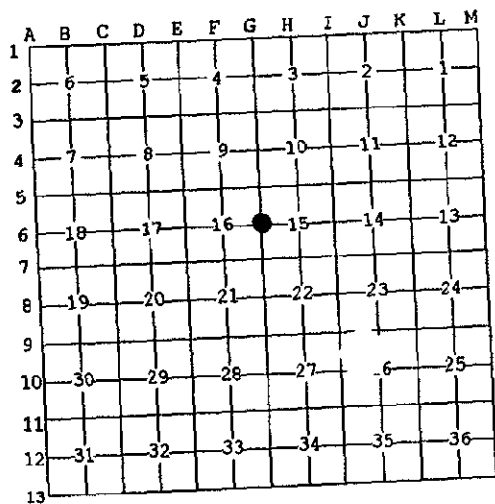

1/4 Corner common to Sections 15 & 16, T48N R39W.

Earl W. Applekamp, in a field survey on 09-30, 1996 do hereby state that under requirements of P.A. 74, Michigan P.A. of 1970, the corner points mentioned in lines 1 and 2 above were in conformance with regulations and rules therefore as required in the current manual of survey instructions of the United States Department of the Interior, Bureau of Land Management or by a decree of a Court of Law and/or that the corner points mentioned in lines 3, 4 and 5 above were in conformance with the rules of the Michigan Board of Land Surveyors or by a Decree of a Court of Law; established, re-established, monumented, recovered, found as expressed below:

NOTE: Not more than 2 corners, all in the same town and range, may be recorded on this certificate.

A. Description of original monument and accessories and/or subsequent restoration:  
 Original corner established by Artemas Curtis, U.S. Deputy Surveyor, September 16, 1851. Set Wood Post.

ORIGINAL BEARING TREES:  
 Cedar 8" N35°W 7.26 feet  
 Spruce 9" S80°E 21.12 feet

PEER GROUP APPROVED  
*Earl W. Applekamp*  
 COUNTY REPRESENTATIVE  
 10-16-96

B. Description of corner evidence found and/or method applied in restoring or reestablishing corner:  
 No original evidence was found. Corner position is in US Highway 45 and in a 10 foot cut section. Highway prints do not identify the corner. GLO calls to a stream South is in conformance. Corner was set by single proportionate measurement for a survey by E. W. Applekamp in 1993 and again in 1996. Corner was re-established by single proportionate measurement and on line between opposite section corners.

Research on file with the Ontonagon County Remonumentation Program Representative.

C. Description of monument for corner and accessories established to perpetuate locating the position of the corner:  
 At the corner position I set a R.R. spike in the blacktop, 1 foot WEST of the centerline of Hwy. U.S.-45. I established two reference monuments which are 2 1/2" X 30" split base aluminum pipes with a 3 1/4" cap stamped to read: County Remonumentation, T48N R39W, RM, 1/4, S15, S16, 1996, P.S. 17610. I also established two bearing trees.

REF. MON. N71°-00'-20"W 45.55' - 10" Spruce S64°-56'-34"W 62.54'  
 REF. MON. S70°-43'-27"E 73.55' - 10" W. Pine S31°-11'-19"E 117.64'



Signed by Earl W. Applekamp  
 Surveyor's Michigan License No. 17610

Date October 10, 1996