

LAND CORNER RECORDATION CERTIFICATE
 Filing Requirement of Act 74, Mich. P.A. 1970

For corners in

<u>ONTONAGON</u> (County)	Located In:	Corner Code #
1. Public Land Survey	T <u>48N</u> R <u>39W</u>	<u>G-8</u>
	T ___ R ___	___
	T ___ R ___	___
	T ___ R ___	___
2. Property Controlling in Section	S ___ T ___ R ___	___
	S ___ T ___ R ___	___
3. Miscellaneous Property in Sec.	S ___ T ___ R ___	___
	S ___ T ___ R ___	___

**SURVEY &
 REMONUMENTATION**

MAY 22 1997

COMMISSION

Register of Deeds Stamp & File Number

4. Lot No. _____, Recorded Plat _____
 5. Private Claims _____

$\frac{1}{4}$ Corner common to Sections 21 & 22, T48N R39W.

I, Earl W. Applekamp, in a field survey on August 01 1996 do hereby state that under requirements of P.A. 74, Michigan P.A. of 1970, the corner points mentioned in lines 1 and 2 above were in conformance with regulations and rules therefore as required in the current manual of survey instructions of the United States Department of the Interior, Bureau of Land Management or by a decree of a Court of Law and/or that the corner points mentioned in lines 3, 4 and 5 above were in conformance with the rules of the Michigan Board of Land Surveyors or by a Decree of a Court of Law; established, re-established, monumented, recovered, found as expressed below:

NOTE: Not more than 2 corners, all in the same town and range, may be recorded on this certificate.

A	B	C	D	E	F	G	H	I	J	K	L	M
1												
2	6	5	4	3	2	1						
3												
4	7	8	9	10	11	12						
5												
6	18	17	16	15	14	13						
7												
8	19	20	21	22	23	24						
9												
10	30	29	28	27	26	25						
11												
12	31	32	33	34	35	36						
13												

A. Description of original monument and accessories and/or subsequent restoration:

Original corner established by Artemas Curtis U.S. Deputy Surveyor, September 17, 1851. Set Wood Post.

ORIGINAL BEARING TREES:

W. Pine 14" N20°W 23.10 feet
 Y. Birch 11" S20°E 6.60 feet

B. Description of corner evidence found and/or method applied in restoring or reestablishing corner:

No original evidence was found. Corner was re-established by single proportionate measurement and on line between opposite section corners North & South. Corner position is 3" East of the centerline of U.S. Highway 45.


Research on file with the Ontonagon County Remonumentation Program Representative.

PEER GROUP APPROVED
Earl W. Applekamp 9-12-96
 COUNTY REPRESENTATIVE

C. Description of monument for corner and accessories established to perpetuate locating the position of the corner:

At the corner position I set a $\frac{1}{2}$ "x5" rebar flush with the top of blacktop in Highway US-45. I established two reference monuments which are 2 $\frac{1}{2}$ "x30" aluminum pipes with 3 $\frac{1}{2}$ " caps stamped to read: County Remonumentation, T48N R39W, R.M., $\frac{1}{4}$, S21, S22, 1996, P.S. 17610. I also established two other reference objects.

REF. MON. S88°-49'-29"W 48.62' - P. Pole N31°-18'-45"W 121.62'
 REF. MON. S88°-56'-39"E 57.96' - Punch in M.H. Rim S61°-34'-17"E 48.39'

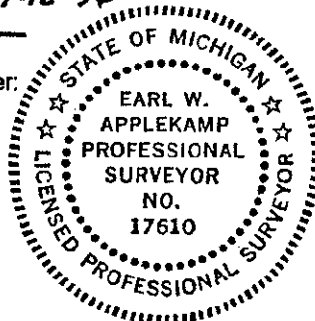

Signed by *Earl W. Applekamp*
 Surveyor's Michigan License No. 17610

Date August 17, 1996