


**LAND CORNER RECORDATION CERTIFICATE**  
 Filing Requirement of Act 74, Mich. P.A. 1970

For corners in

ONTONAGON (County)	Located In:	Corner Code #
1. Public Land Survey	T <u>T48NR 39W</u>	<u>H-5</u>
	T ___ R ___	_____
	T ___ R ___	_____
	T ___ R ___	_____
2. Property Controlling in Section	S ___ T ___ R ___	_____
	S ___ T ___ R ___	_____
3. Miscellaneous Property In Sec.	S ___ T ___ R ___	_____
	S ___ T ___ R ___	_____

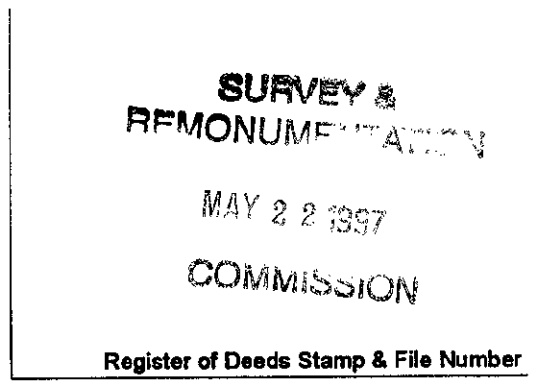

4. Lot No. \_\_\_\_\_, Recorded Plat \_\_\_\_\_  
 5. Private Claims \_\_\_\_\_

1/4 Corner common to Sections 10 & 15, T48N R39W.

I, Earl W. Applekamp, in a field survey on 09-30, 1996 do hereby state that under requirements of P.A. 74, Michigan P.A. of 1970, the corner points mentioned in lines 1 and 2 above were in conformance with regulations and rules therefore as required in the current manual of survey instructions of the United States Department of the Interior, Bureau of Land Management or by a decree of a Court of Law and/or that the corner points mentioned in lines 3, 4 and 5 above were in conformance with the rules of the Michigan Board of Land Surveyors or by a Decree of a Court of Law, established, re-established, monumented, recovered, found as expressed below:

NOTE: Not more than 2 corners, all in the same town and range, may be recorded on this certificate.

	A	B	C	D	E	F	G	H	I	J	K	L	M
1													
2	6			5			4			3		2	1
3													
4	7			8			9			10		11	12
5								●					
6	18			17			16			15		14	13
7													
8	19			20			21			22		23	24
9													
10	30			29			28			27		26	25
11													
12	31			32			33			34		35	36
13													

A. Description of original monument and accessories and/or subsequent restoration:

Original corner established by Artemas Curtis, U.S. Deputy Surveyor, September 23, 1851. Set Wood Post.

ORIGINAL BEARING TREES:

Y. Birch 12" N25°E 17.82 feet  
 Hemlock 14" S50°W 33.00 feet

PEER GROUP APPROVED  
Earl W. Applekamp  
 COUNTY REPRESENTATIVE  
 10-16-96

B. Description of corner evidence found and/or method applied in restoring or reestablishing corner:

No original evidence was found. A fence line runs North from the calculated corner position and a blacktop road runs East and West. The land North and South of the corner position is being farmed and has been for 50 plus years. Corner was re-established at the fence line running North and in the centerline of the blacktop road. This position is less than 1 foot of being an equal split East and West. The East-West line deflects 7.5 minutes at the corner.

Research on file with the Ontonagon County Remonumentation Program Representative.

C. Description of monument for corner and accessories established to perpetuate locating the position of the corner:

At the corner position I set a 5/8"x24" rebar with a stamped 3 1/4" aluminum cap 2" below the top of blacktop. I established one reference monument, a 2 1/2"x30" aluminum pipe with a 3 1/4" cap stamped to read: County Remonumentation, T48N R39W, R.M., 1/4, S10, S15, 1996, P.S. 17610. I also established three other reference objects.



REF. MON. N06°-46'-37"E 33.51' - 16" Apple Tree S03°-13'- 51"W 399.60'  
 P. Pole #419 N80°-44'-27"W 207.33' - P. Pole #418 N72°-30'-48"E 112.29'

Signed by Earl W. Applekamp Date October 10, 1996  
 Surveyor's Michigan License No. 17610