

SURVEY & REMONUMENTATION

APR 29 1996

COMMISSION

JUDITH D. ROEHM
Ontonagon County
LC 4/ 12 JEM Fee: 9.00
Page 1 of 1

LAND CORNER RECORDATION CERTIFICATE
Filing Requirement of Act 74, Mich. P.A. 1970

For corners in


ONTONAGON (County)	Located in:	Corner Code #
1. Public Land Survey	T 48N R 39W	H-7
	T ___ R ___	_____
	T ___ R ___	_____
	T ___ R ___	_____
2. Property Controlling in Section	S ___ T ___ R ___	_____
	S ___ T ___ R ___	_____
3. Miscellaneous Property in Sec.	S ___ T ___ R ___	_____
	S ___ T ___ R ___	_____

Register of Deeds Stamp & File Number

4. Lot No. _____, Recorded Plat _____
5. Private Claims _____

1/4 Corner common to Section 15 & 22, T48N R39W.

I, Earl W. Applekamp, in a field survey on July 27, 1995 do hereby state that under requirements of P.A. 74, Michigan P.A. of 1970, the corner points mentioned in lines 1 and 2 above were in conformance with regulations and rules therefore as required in the current manual of survey instructions of the United States Department of the Interior, Bureau of Land Management or by a decree of a Court of Law and/or that the corner points mentioned in lines 3, 4 and 5 above were in conformance with the rules of the Michigan Board of Land Surveyors or by a Decree of a Court of Law; established, re-established, monumented, recovered, found as expressed below:

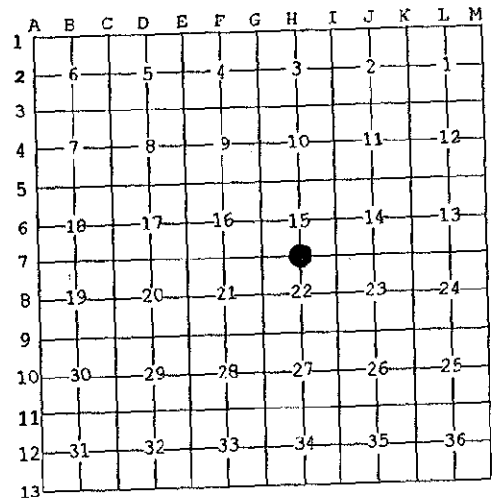

NOTE: Not more than 2 corners, all in the same town and range, may be recorded on this certificate.

A. Description of original monument and accessories and/or subsequent restoration:

Original corner established by Artemus Curtis, U.S. Deputy Surveyor, September 21, 1851. Set Post.

ORIGINAL BEARING TREES:

Maple 10" N60°W 35 links (23.10 feet)
Hemlock 7" S40°E 7 links (4.62 feet)

B. Description of corner evidence found and/or method applied in restoring or reestablishing corner:

At the apparent corner location I found a 1" axle shaft 6" below top of gravel in the centerline of a road running East and West. An old fence line ran North from this location. A recent logging operation had taken place SE of this position, using a line running South from this location. The distance from the axle shaft to the NW Corner of Section 22 was in agreement with the original field notes. With this evidence I accepted the axle shaft as the true position of the corner and monumented it as described in "C".

Research on file.

C. Description of monument for corner and accessories established to perpetuate locating the position of the corner:

At the corner position I set a 3/4"x16" long aluminum rod with a 3 1/4" cap 6" below top of gravel. Cap is stamped to read: COUNTY REMONUMENTATION, 1/4, S15, S22, T48N R39W, 1995, P.S. 17610. I established the following bearing trees and reference objects.

7" Maple N36°W 44.35 feet - REA Pwr. Pole S02°W 35.18 feet
9" Red Pine N41°E 31.69 feet - Steel Sign Post, North 20.22 feet



Signed by Earl W. Applekamp
Surveyor's Michigan License No. 17610

Date December 06, 1995

PEER GROUP APPROVED
Earl W. Applekamp 12-14-95
COUNTY REPRESENTATIVE