

LAND CORNER RECORDATION CERTIFICATE
 Filing Requirement of Act 74, Mich. P.A. 1970

For corners in

ONTONAGON
 (County)

Located In:

Corner Code #

- | | | | |
|------------------------------------|------|-----------|-------|
| 1. Public Land Survey | | T48N R39W | H-9 |
| | | T___ R___ | _____ |
| | | T___ R___ | _____ |
| | | T___ R___ | _____ |
| 2. Property Controlling in Section | S___ | T___ R___ | _____ |
| | S___ | T___ R___ | _____ |
| 3. Miscellaneous Property in Sec. | S___ | T___ R___ | _____ |
| | S___ | T___ R___ | _____ |

SURVEY &
 REMONUMENTATION

OCT 30 1997

COMMISSION

Register of Deeds Stamp & File Number

4. Lot No. _____, Recorded Plat _____
 5. Private Claims _____

$\frac{1}{4}$ Corner common to Sections 22 & 27, T48N R39W.

I, Earl W. Applekamp, in a field survey on June 20, 1997 do hereby state that under requirements of P.A. 74, Michigan P.A. of 1970, the corner points mentioned in lines 1 and 2 above were in conformance with regulations and rules therefore as required in the current manual of survey instructions of the United States Department of the Interior, Bureau of Land Management or by a decree of a Court of Law and/or that the corner points mentioned in lines 3, 4 and 5 above were in conformance with the rules of the Michigan Board of Land Surveyors or by a Decree of a Court of Law; established, re-established, monumented, recovered, found as expressed below:

NOTE: Not more than 2 corners, all in the same town and range, may be recorded on this certificate.

A	B	C	D	E	F	G	H	I	J	K	L	M
1												
2	6		5		4		3		2		1	
3												
4	7		8		9		10		11		12	
5												
6	18		17		16		15		14		13	
7												
8	19		20		21		22		23		24	
9												
10	30		29		28		27		26		25	
11												
12	31		32		33		34		35		36	
13												

A. Description of original monument and accessories and/or subsequent restoration:

Original corner established by Artemas Curtis, U.S. Deputy Surveyor, September 20, 1851. Set Wood Post.

ORIGINAL BEARING TREES:

- | | | |
|-------------|-------|------------|
| 24" W. Pine | N37°E | 10.56 feet |
| 36" W. Pine | S45°W | 30.36 feet |

B. Description of corner evidence found and/or method applied in restoring or reestablishing corner:

No original evidence was found. Corner position is in Michigan Highway M-28. Several surveys were performed in the area using single proportionate measure for the $\frac{1}{4}$ corner. I re-established the $\frac{1}{4}$ corner by single proportionate measure and on line between opposite section corners.

Research on file with the Ontonagon County Remonumentation Program Representative.


FREE GROUP APPROVED 8-13-97

Earl W. Applekamp
 COUNTY REPRESENTATIVE

C. Description of monument for corner and accessories established to perpetuate locating the position of the corner:

At the corner position I set a R.R. Spike with punch mark one foot South of Highway M-28. I established two reference monuments which are 2 $\frac{1}{2}$ "X30" aluminum pipe with a 3" cap stamped to read: County Remonumentation, T48N R39W, R.M., $\frac{1}{4}$, S22, S27, 1997, P.S. 17610. I also established two other reference objects.

- | | | | | | |
|-----------|---------------|--------|-----------|---------------|---------|
| REF. MON. | S29°-08'-54"W | 88.53' | - P. Pole | S74°-14'-24"W | 234.71' |
| REF. MON. | N29°-46'-06"W | 93.70' | - P. Pole | S39°-50'-07"E | 81.35' |

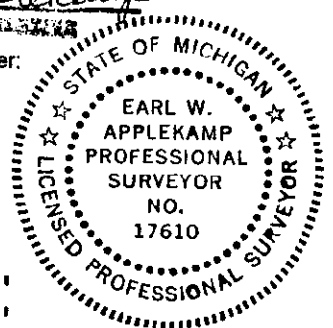

Signed by Earl W. Applekamp
 Surveyor's Michigan License No. 17610

Date July 26, 1997