

LAND CORNER RECORDATION CERTIFICATE
Filing Requirement of Act 74, Mich. P.A. 1970

For corners in

<u>ONTONAGON</u> (County)	Located in:	Corner Code #
1. Public Land Survey	T <u>48N</u> R <u>39W</u>	<u>H-11</u>
	T ___ R ___	_____
	T ___ R ___	_____
	T ___ R ___	_____
2. Property Controlling in Section	S ___ T ___ R ___	_____
	S ___ T ___ R ___	_____
3. Miscellaneous Property in Sec.	S ___ T ___ R ___	_____
	S ___ T ___ R ___	_____

RECORDED
 OCT 8 0 1997
 COMMISSIONER
 Register of Deeds Stamp & File Number

4. Lot No. _____, Recorded Plat _____
 5. Private Claims _____

$\frac{1}{4}$ Corner common to Sections 27 & 34, T48N R39W.

I, Earl W. Applekamp, in a field survey on Aug. 18, 1997 do hereby state that under requirements of P.A. 74, Michigan P.A. of 1970, the corner points mentioned in lines 1 and 2 above were in conformance with regulations and rules therefore as required in the current manual of survey instructions of the United States Department of the Interior, Bureau of Land Management or by a decree of a Court of Law and/or that the corner points mentioned in lines 3, 4 and 5 above were in conformance with the rules of the Michigan Board of Land Surveyors or by a Decree of a Court of Law; established, re-established, monumented, recovered, found as expressed below:

NOTE: Not more than 2 corners, all in the same town and range, may be recorded on this certificate.

A	B	C	D	E	F	G	H	I	J	K	L	M
1												
2	6	5	4	3	2	1						
3												
4	7	8	9	10	11	12						
5												
6	18	17	16	15	14	13						
7												
8	19	20	21	22	23	24						
9												
10	30	29	28	27	26	25						
11												
12	31	32	33	34	35	36						
13												

A. Description of original monument and accessories and/or subsequent restoration:

Original corner established by Artemas Curtis, U.S. Deputy Surveyor, September 20, 1851. Set Wood Post.

ORIGINAL BEARING TREES:

10" Cedar N40°W 11.22 feet
 10" Cedar S35°E 1.98 feet

B. Description of corner evidence found and/or method applied in restoring or reestablishing corner:

No original evidence was found. Corner was re-established by single proportioned measure between opposite section corners. Corner falls on the North edge of a 100 foot wide cleared R.O.W. for the Wisconsin Electric Power line and in an extremely wet swamp.


Research on file with the Ontonagon County Remonumentation Program Representative.

C. Description of monument for corner and accessories established to perpetuate locating the position of the corner:

At the corner position I set a $2\frac{1}{2}$ "X30" aluminum pipe with a 3" cap stamped to read: County Remonumentation, T48N R39W, $\frac{1}{4}$, S27, S34, 1997, P.S. 17610. I established 3 bearing trees and a reference object.

26" Cedar N71°W 37.48' - 13" White Birch S22°E 116.25'
 8" Balsam N25°E 31.08' - Steel Sign Post, East 1.04'

PEER GROUP APPROVED
Earl W. Applekamp
 COUNTY REPRESENTATIVE
 9-17-97

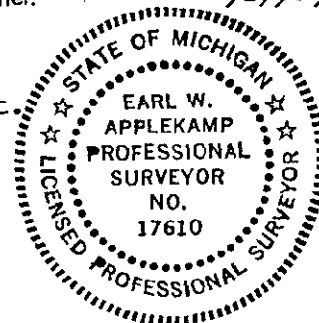

Signed by Earl W. Applekamp
 Surveyor's Michigan License No. 17610

Date August 21, 1997