

OCT 30 1997

COMMISSION

LAND CORNER RECORDATION CERTIFICATE  
Filing Requirement of Act 74, Mich. P.A. 1970

For corners in

ONTONAGON  
(County)

Located In:

Corner Code #

- 1. Public Land Survey      T 48N R 39W      I-4
- T \_\_\_ R \_\_\_      \_\_\_\_\_
- T \_\_\_ R \_\_\_      \_\_\_\_\_
- T \_\_\_ R \_\_\_      \_\_\_\_\_
- 2. Property Controlling    S \_\_\_ T \_\_\_ R \_\_\_      \_\_\_\_\_
- in Section                S \_\_\_ T \_\_\_ R \_\_\_      \_\_\_\_\_
- 3. Miscellaneous            S \_\_\_ T \_\_\_ R \_\_\_      \_\_\_\_\_
- Property in Sec.         S \_\_\_ T \_\_\_ R \_\_\_      \_\_\_\_\_

JUDITH D. ROEHM      06/12/97  
 Ontonagon County    09:43  
 LC 4/270 JTT      Feet: 9.00  
 Page 1 of 1


Register of Deeds Stamp & File Number

- 4. Lot No. \_\_\_\_\_, Recorded Plat \_\_\_\_\_
- 5. Private Claims \_\_\_\_\_

Quarter Corner common to Sections 10 & 11, T48N R39W.

I, Earl W. Applekamp, in a field survey on May 30, 1997 do hereby state that under requirements of P.A. 74, Michigan P.A. of 1970, the corner points mentioned in lines 1 and 2 above were in conformance with regulations and rules therefore as required in the current manual of survey instructions of the United States Department of the Interior, Bureau of Land Management or by a decree of a Court of Law and /or that the corner points mentioned in lines 3, 4 and 5 above were in conformance with the rules of the Michigan Board of Land Surveyors or by a Decree of a Court of Law; established, re-established, monumented, recovered, found as expressed below:

NOTE: Not more than 2 corners, all in the same town and range, may be recorded on this certificate.

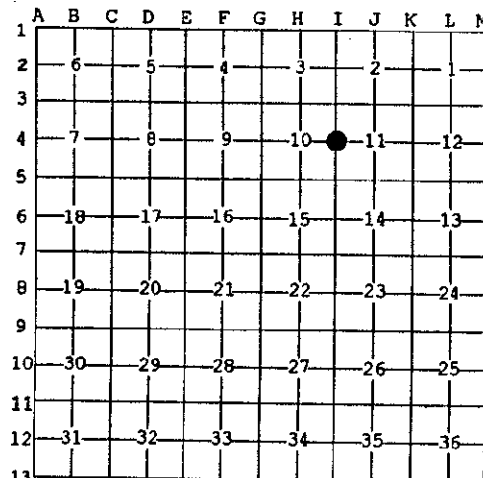

A. Description of original monument and accessories and/or subsequent restoration:

Original corner established by Artemas Curtis, U.S. Deputy Surveyor, September 1851. Set Wood Post.

ORIGINAL BEARING TREES:

- 6" White Ash      N60°E      5.94 feet
- 12" Spruce        S55°W      21.12 feet

B. Description of corner evidence found and/or method applied in restoring or reestablishing corner:

No original evidence was found, Corner position falls on a county gravel road running North & South. Farming is taking place on both sides of the road. No trees remain. Corner was re-established by single proportionate measure and on line between opposite Section corners. Corner falls in the center-line of the gravel road.

Research on file with the Ontonagon County Remonumentation Program Representative.

DEER GROUP APPROVED  
*Earl W. Applekamp*  
 COUNTY REPRESENTATIVE 6-10-97

C. Description of monument for corner and accessories established to perpetuate locating the position of the corner:

At the corner position I set a 5/8"x12" rebar with a 3" stamped cap 6" below top of the gravel road. I established a reference monument, a 2 1/2"x30" aluminum pipe with a 3" cap stamped to read: County Remonumentation, T48N, R39W, R.M., 1/4, S10, S11, 1997, P.S. 17610. I established two other witness objects.

- REF. MON.    N54°W    38.62 feet    Power Pole    N57°W    35.98 feet
- 7" Twin Apple Tree    S17°E    91.84 feet



Signed by Earl W. Applekamp  
 Surveyor's Michigan License No. 17610

Date June 7, 1997